


F.H.W.A. REGION	STATE	PROJECT NO.	SHEET NO.	TOTAL SHEETS	AS BUILT
9	ARIZ.	NH-093-B(008)B	33	380	
93 MA 198					

REV. NO.	LOCATION	DATE	BY
▲	REVISED ROUNDABOUTS	10/3/07	BSW
▲	REVISED QUANTITIES	10/19/07	BSW



LOCATION: FINISHED PLANS- REVISIONS: REV. NO.: DATE: LOCATION: FINISHED PLANS- SURVEY NO.:

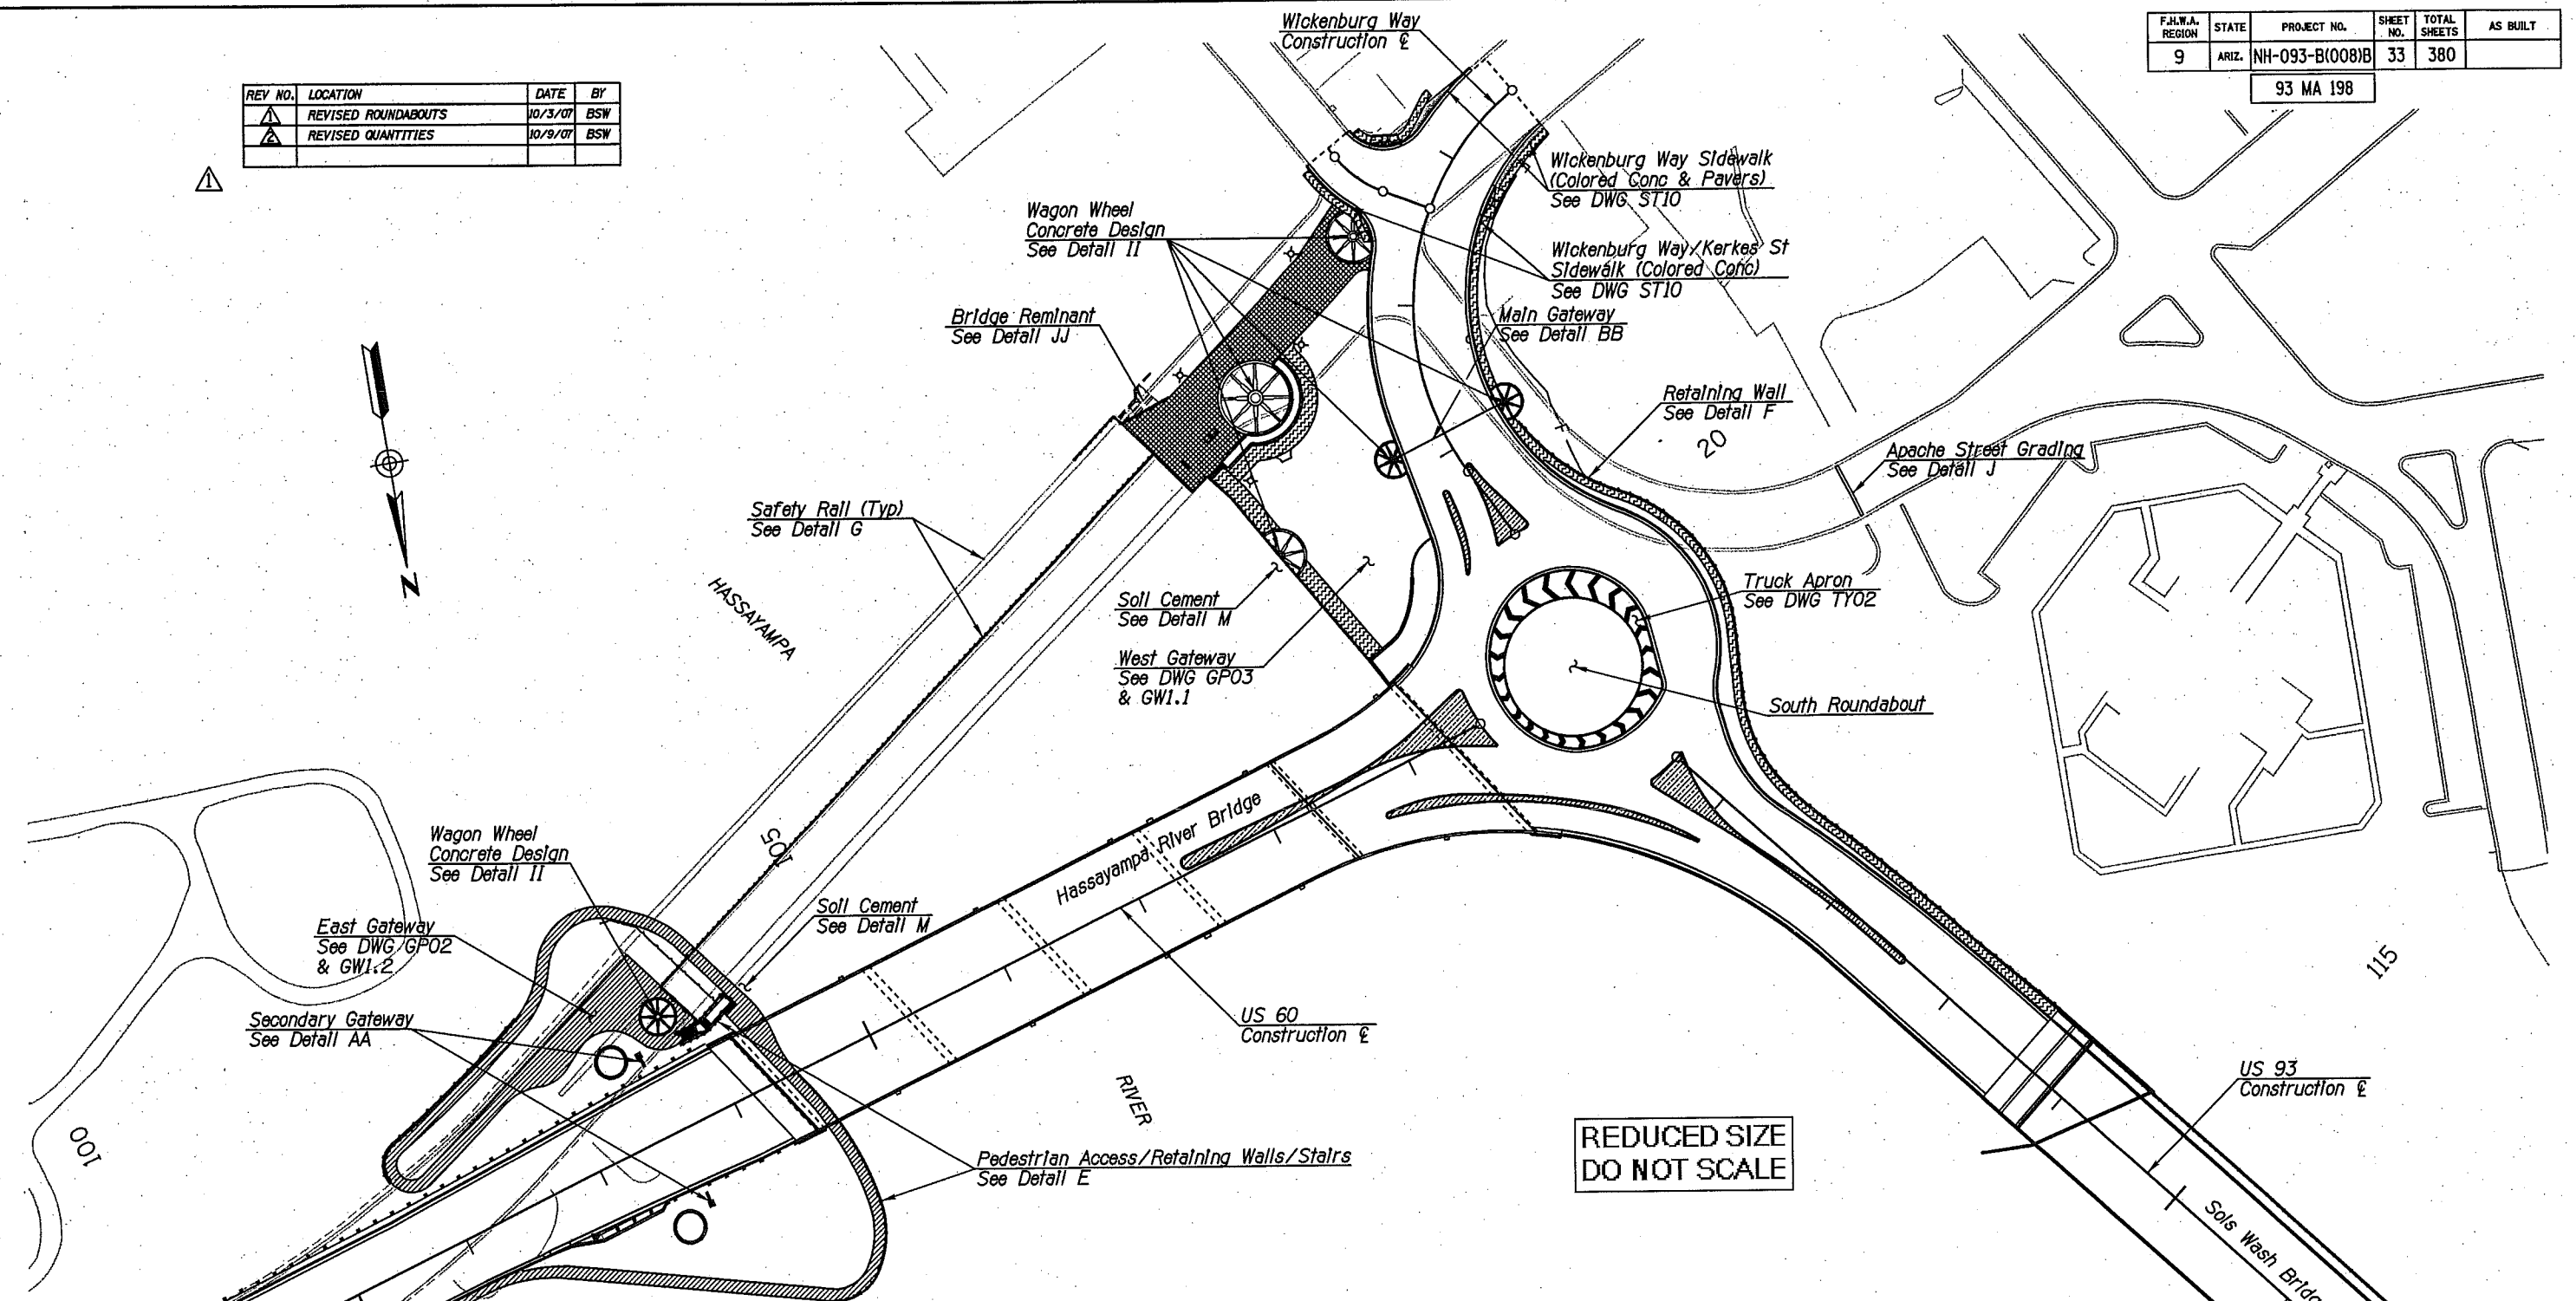

REDUCED SIZE
DO NOT SCALE

LEGEND

Description:	Total Area (This Sheet)
4" Concrete Sidewalk (Std C-05.20)	11,894 SF
4" Colored Concrete Sidewalk (Davis Color 160-'Sunset Rose') (Std C-05.20)	7,007 SF ▲
6" Colored Concrete Sidewalk (Davis Color 160-'Sunset Rose') (Std C-05.20)	7,024 SF
9" Colored and Patterned Concrete (Davis Color 677-'Kahlua Brown') (4"x4" Granite Setts)	1,011 SF
9" Colored and Patterned Concrete (Davis Color 5447-'Mesa Buff') (4"x4" Granite Setts)	2,626 SF
4" Stamped Colored Concrete (I-Block Shape) (Davis Color 160-'Sunset Rose')	4,899 SF
6" Integral Colored Concrete	4,394 SF ▲
Colored Concrete Pavers (I-Block Shape)	242 SF

DETAIL H

SIDEWALK / CONCRETE KEYMAP

DESIGN	BWR/PJB	DATE	06-07	ARIZONA DEPARTMENT OF TRANSPORTATION INTERMODAL TRANSPORTATION DIVISION	
DRAWN	ASJ/SR	DATE	06-07		
CHECKED	BSW	DATE	06-07		
JE JACOBS		SIDEWALK / CONCRETE KEYMAP			
ROUTE	US 93	LOCATION	WICKENBURG BYPASS	DWG	DT18A
TRACS NO. H 5825 01C			NH-093-B(008)B		
					OF