F.H.W.A. REGION	STATE	PROJECT NO.	SHEET NO.	TOTAL SHEETS	AS BUILT
9	ARIZ.	BRS-355(41)	16	30	

089A YV 384

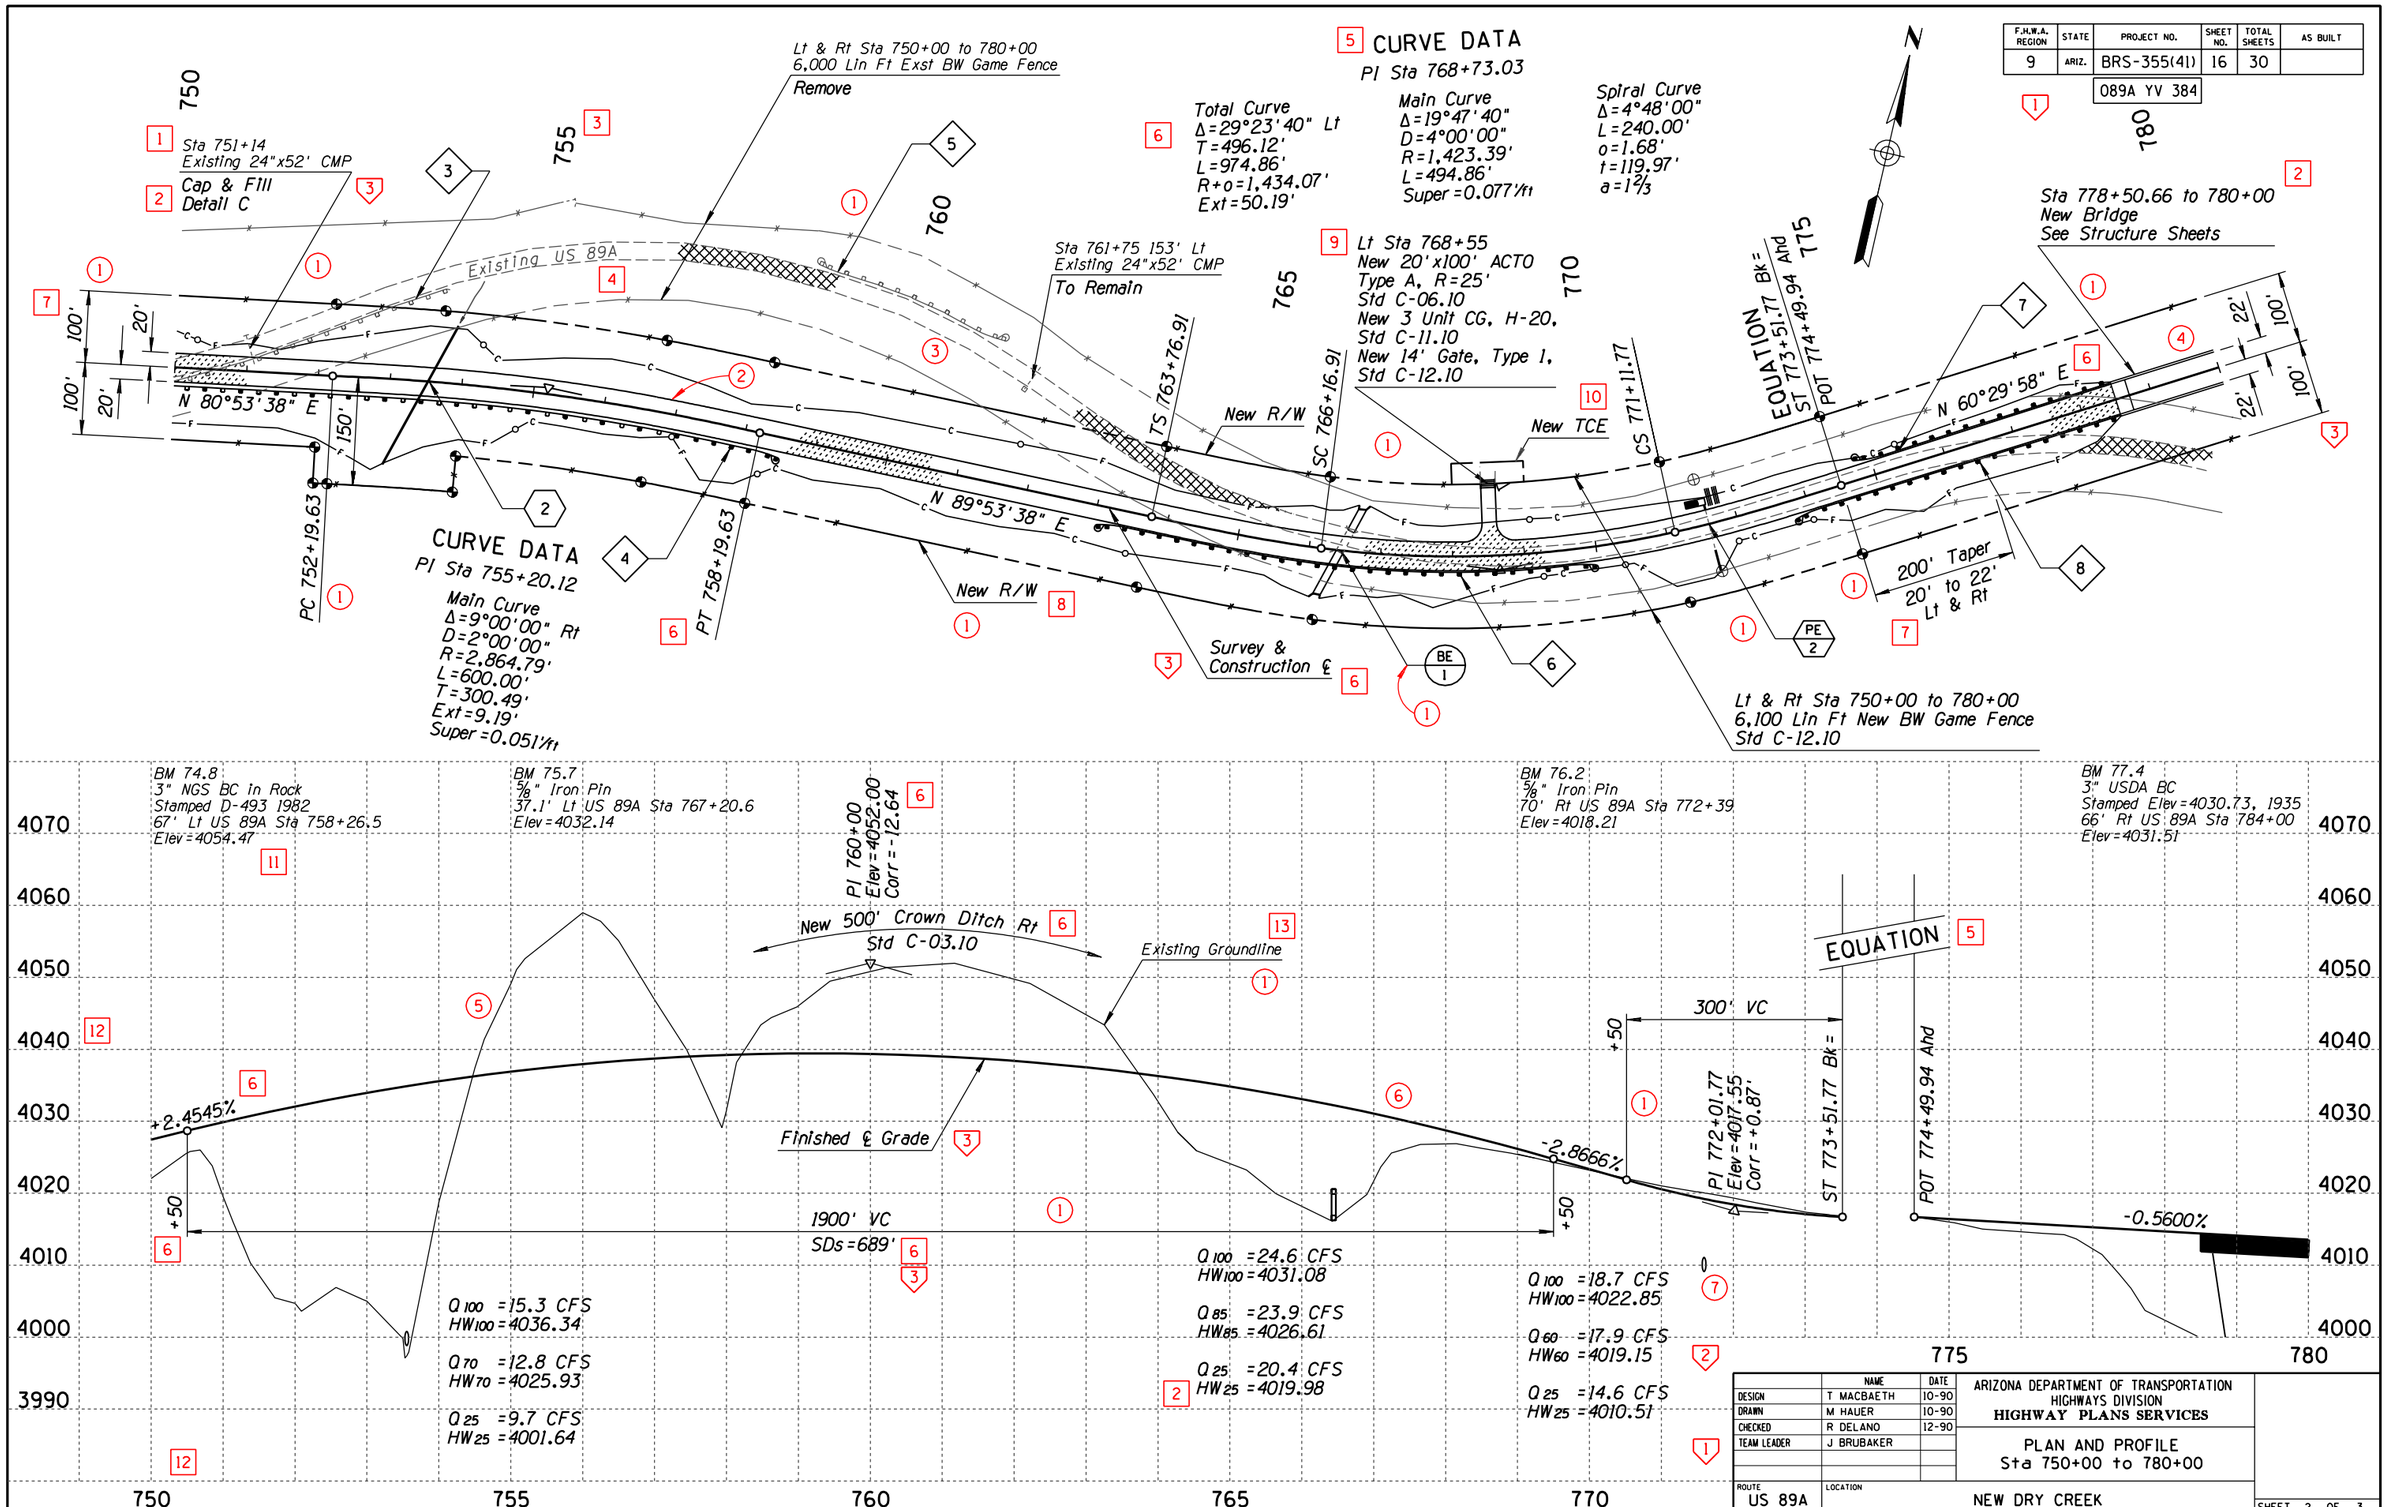

	NAME	DATE
DESIGN	T MACBAETH	10-90
DRAWN	M HAUER	10-90
CHECKED	R DELANO	12-90
TEAM LEADER	J BRUBAKER	

ARIZONA DEPARTMENT OF TRANSPORTATION
HIGHWAYS DIVISION
HIGHWAY PLANS SERVICES

PLAN AND PROFILE
Sta 750+00 to 780+00

ROUTE: US 89A
LOCATION: NEW DRY CREEK

SHEET 2 OF 3

TRACS NO. H0000 01 C

___ OF ___

STD P-07.25

SURVEY NO. | FINISHED PLANS | REVISIONS | LOCATION | DATE

cccccDGNcSPECIFICATIONccccc
ccccSYSTIMEcccc
VIEW NAME: