F.H.W.A. REGION	STATE	PROJECT NO.	SHEET NO.	TOTAL SHEETS	AS BUILT
9	ARIZ.	F-035-1(8)	3	190	

087 GI 202

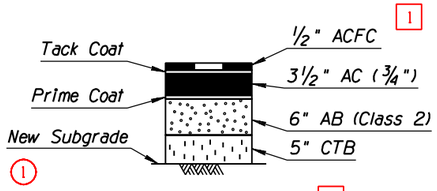

Total Thickness = 15"

SECTION NO. 1

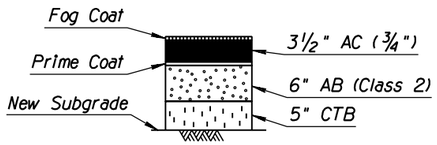

Total Thickness = 14 1/2"

SECTION NO. 2

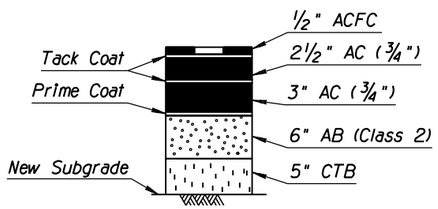

Total Thickness = 17"

SECTION NO. 3

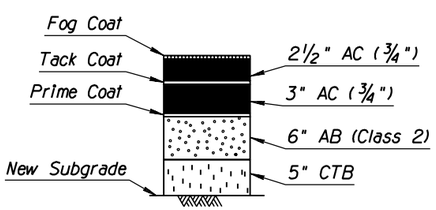

Total Thickness = 16 1/2"

SECTION NO. 4

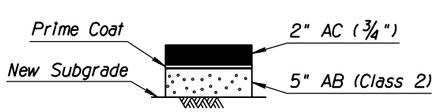

Total Thickness = 7"

SECTION NO. 5

PAVEMENT STRUCTURAL SECTIONS

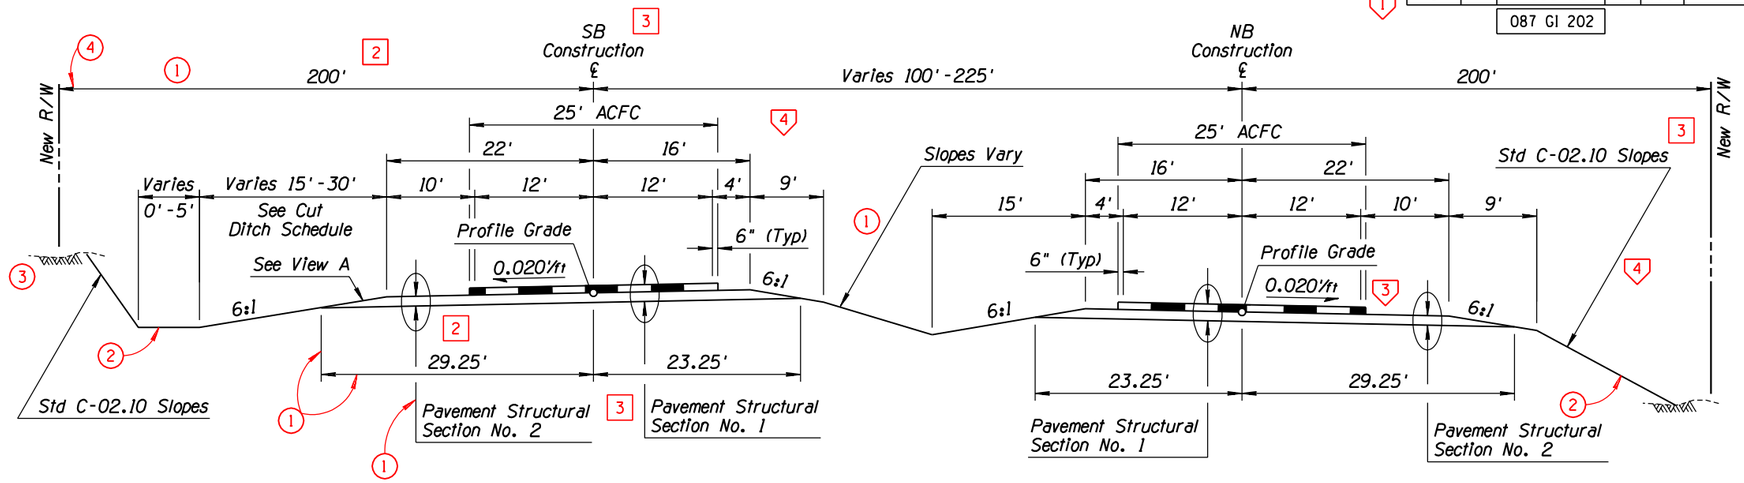

Sta 1442 + 00.00 to 1467 + 94.63
Sta 1487 + 30.46 to 1598 + 55.00

Sta 1441 + 84.36 to 1468 + 35.72
Sta 1487 + 78.51 to 1600 + 75.00

TYPICAL SECTION

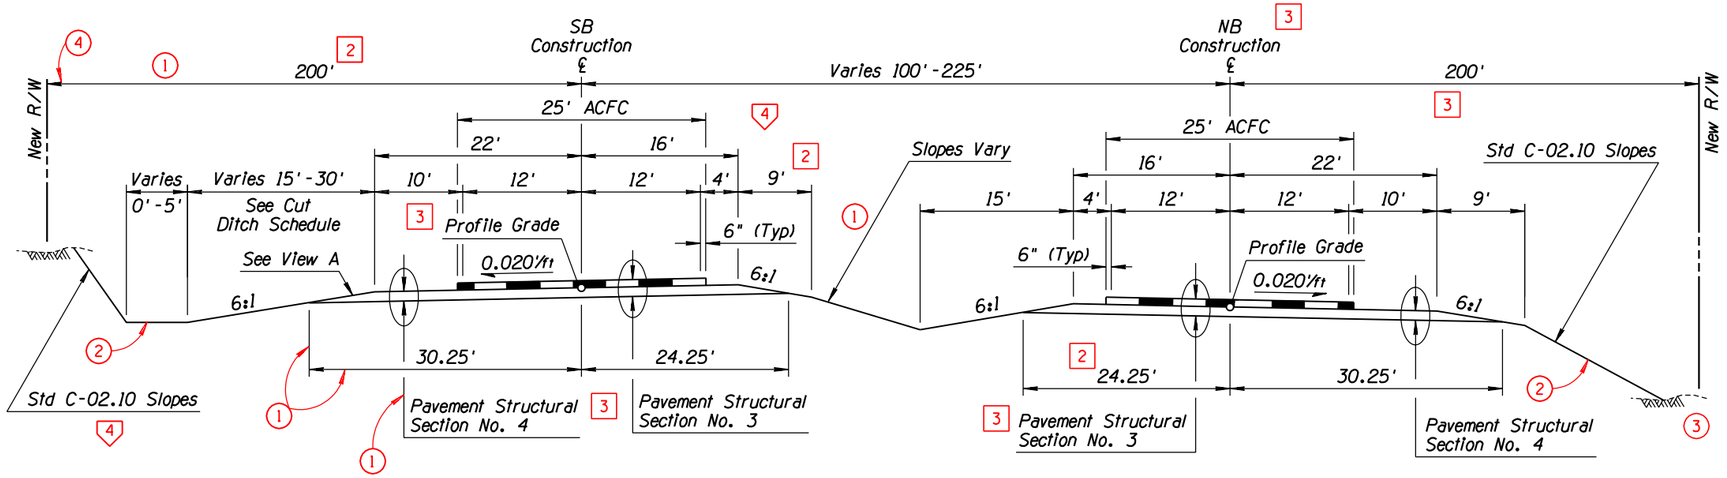

Sta 1625 + 40.00 to 1627 + 68.35 Bk
Sta 124 + 88.79 Ahd to 195 + 80.00

Sta 1629 + 50.00 to 1642 + 24.97 Bk
Sta 135 + 39.21 Ahd to 180 + 68.51

TYPICAL SECTION

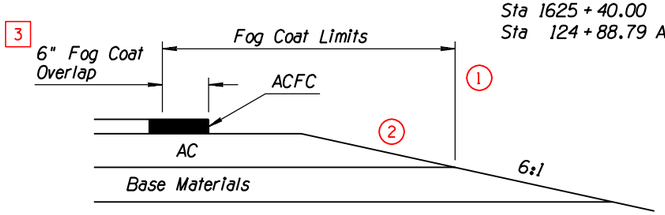

FOG COAT APPLICATION
VIEW A

	NAME	DATE
DESIGN	T MACBETH	10-90
DRAWN	M HAUER	10-90
CHECKED	R DELANO	12-90
TEAM LEADER	J BRUBAKER	

ARIZONA DEPARTMENT OF TRANSPORTATION
HIGHWAYS DIVISION
HIGHWAY PLANS SERVICES

DESIGN SHEET
TYPICAL SECTIONS

ROUTE SR 87 | LOCATION SUNFLOWER - MAZATZAL

SHEET 2 OF 2

STD P-02.15

SURVEY NO. | FINISHED PLANS | REVISIONS | LOCATION | DATE

ccccc DGNcSPECIFICATIONccccc VIEW NAME:
ccccc SYSTIMEccccc

TRACS NO. H0000 01 C

___ OF ___