F.H.W.A. REGION	STATE	PROJECT NO.	SHEET NO.	TOTAL SHEETS	AS BUILT
9	ARIZ.	RBA-600-1-501	4	541	

101L MA 52

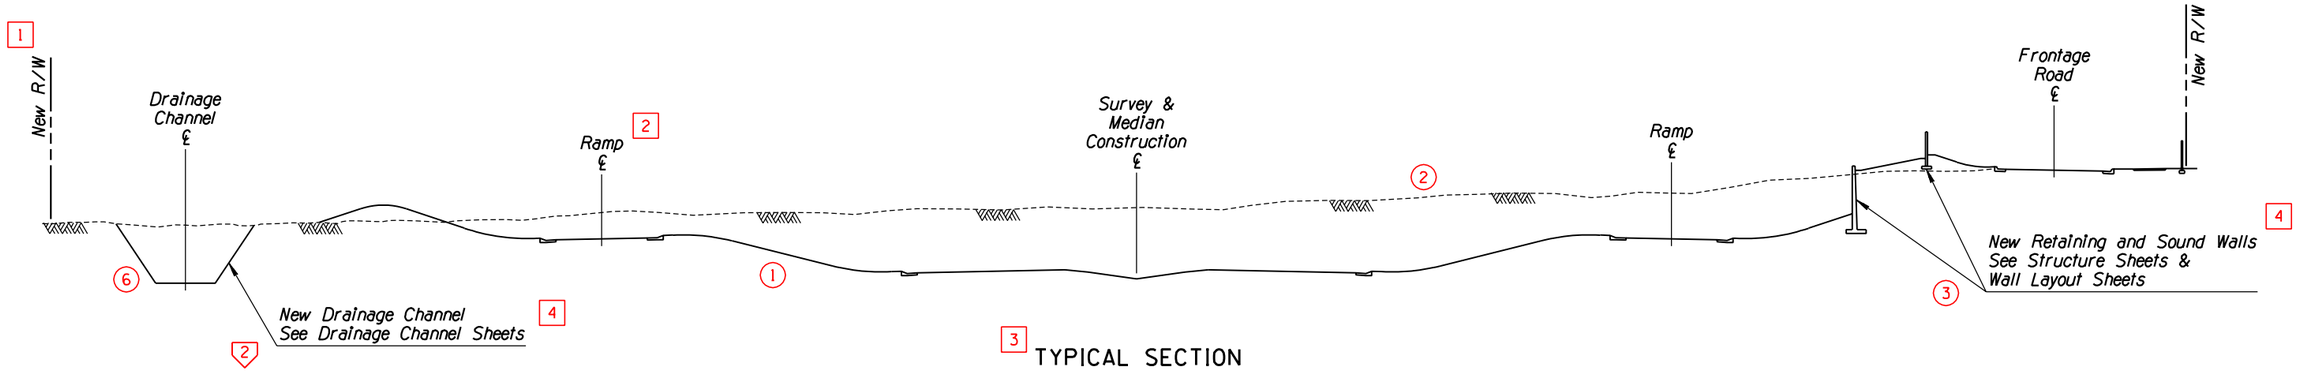

TYPICAL SECTION

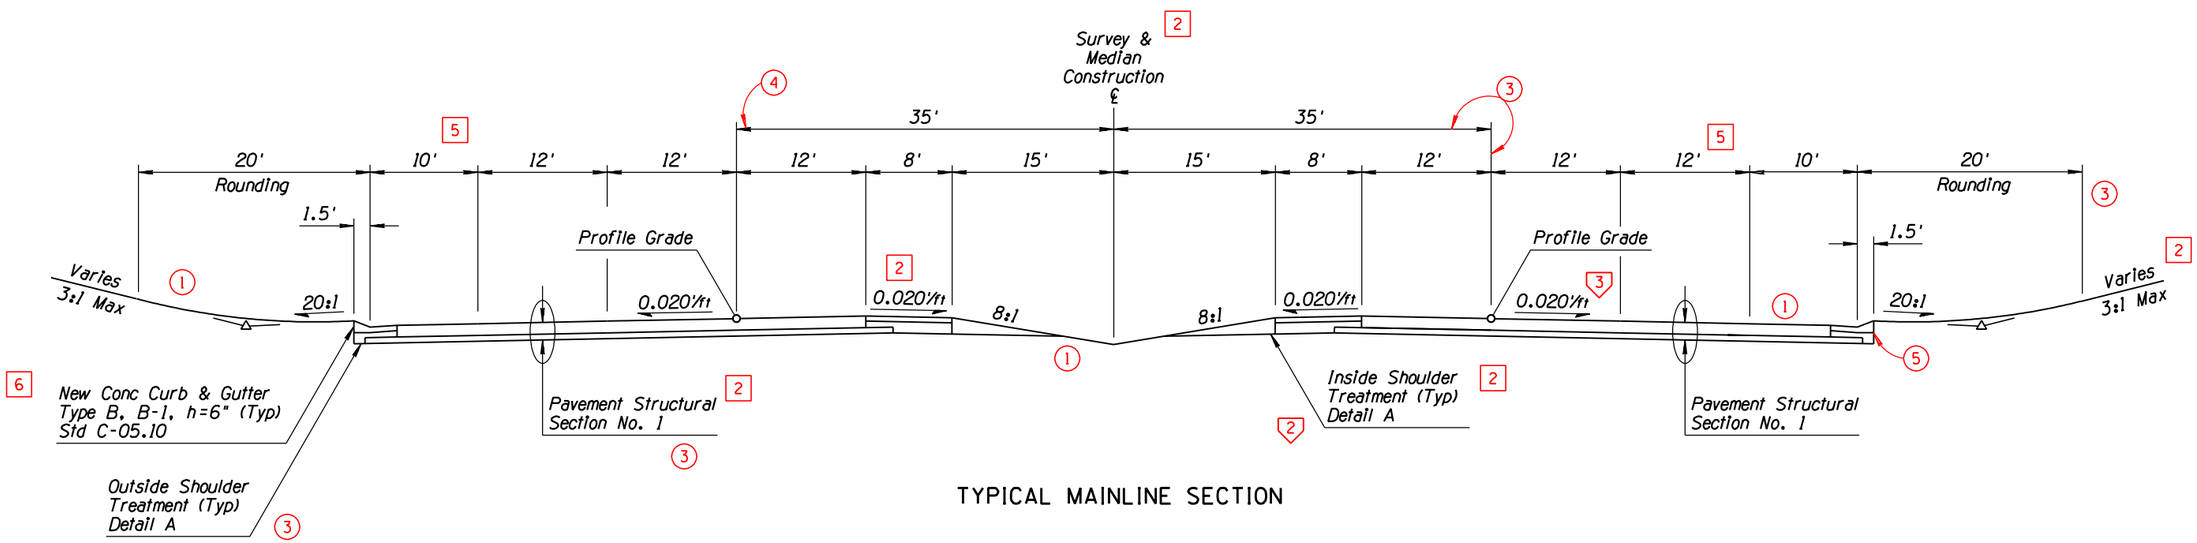

TYPICAL MAINLINE SECTION

	NAME	DATE
DESIGN	T MACBETH	10-90
DRAWN	M HAUER	10-90
CHECKED	R DELANO	12-90
TEAM LEADER	J BRUBAKER	

ARIZONA DEPARTMENT OF TRANSPORTATION
HIGHWAYS DIVISION
HIGHWAY PLANS SERVICES

DESIGN SHEET
TYPICAL SECTIONS

ROUTE: SR 101L
LOCATION: PRICE, FIRST ST - BASELINE

SHEET 3 OF 4

TRACS NO. H0000 01 C

___ OF ___

SURVEY NO.	FINISHED PLANS	REVISIONS	LOCATION	DATE

cccccDGNcSPECIFICATIONccccc
cccccSYSTIMEccccc
VIEW NAME:

STD P-02.52