F.H.W.A. REGION	STATE	PROJECT NO.	SHEET NO.	TOTAL SHEETS	AS BUILT
9	ARIZ.	BRS-355(41)	9	35	

089A YV 384

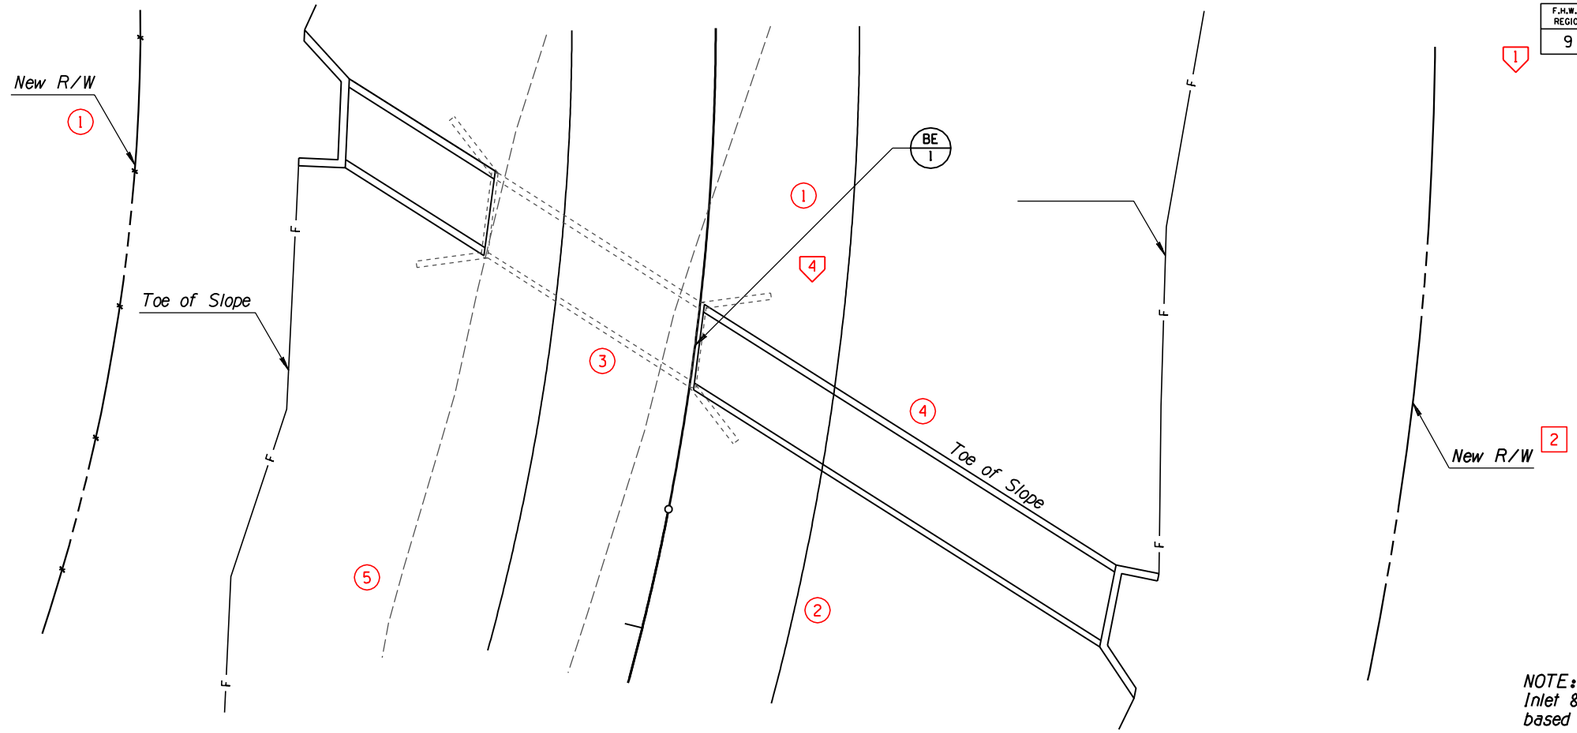

NOTE:
Inlet & outlet wingwall dimensions shall be based on 45° skew with 6:1 slopes.

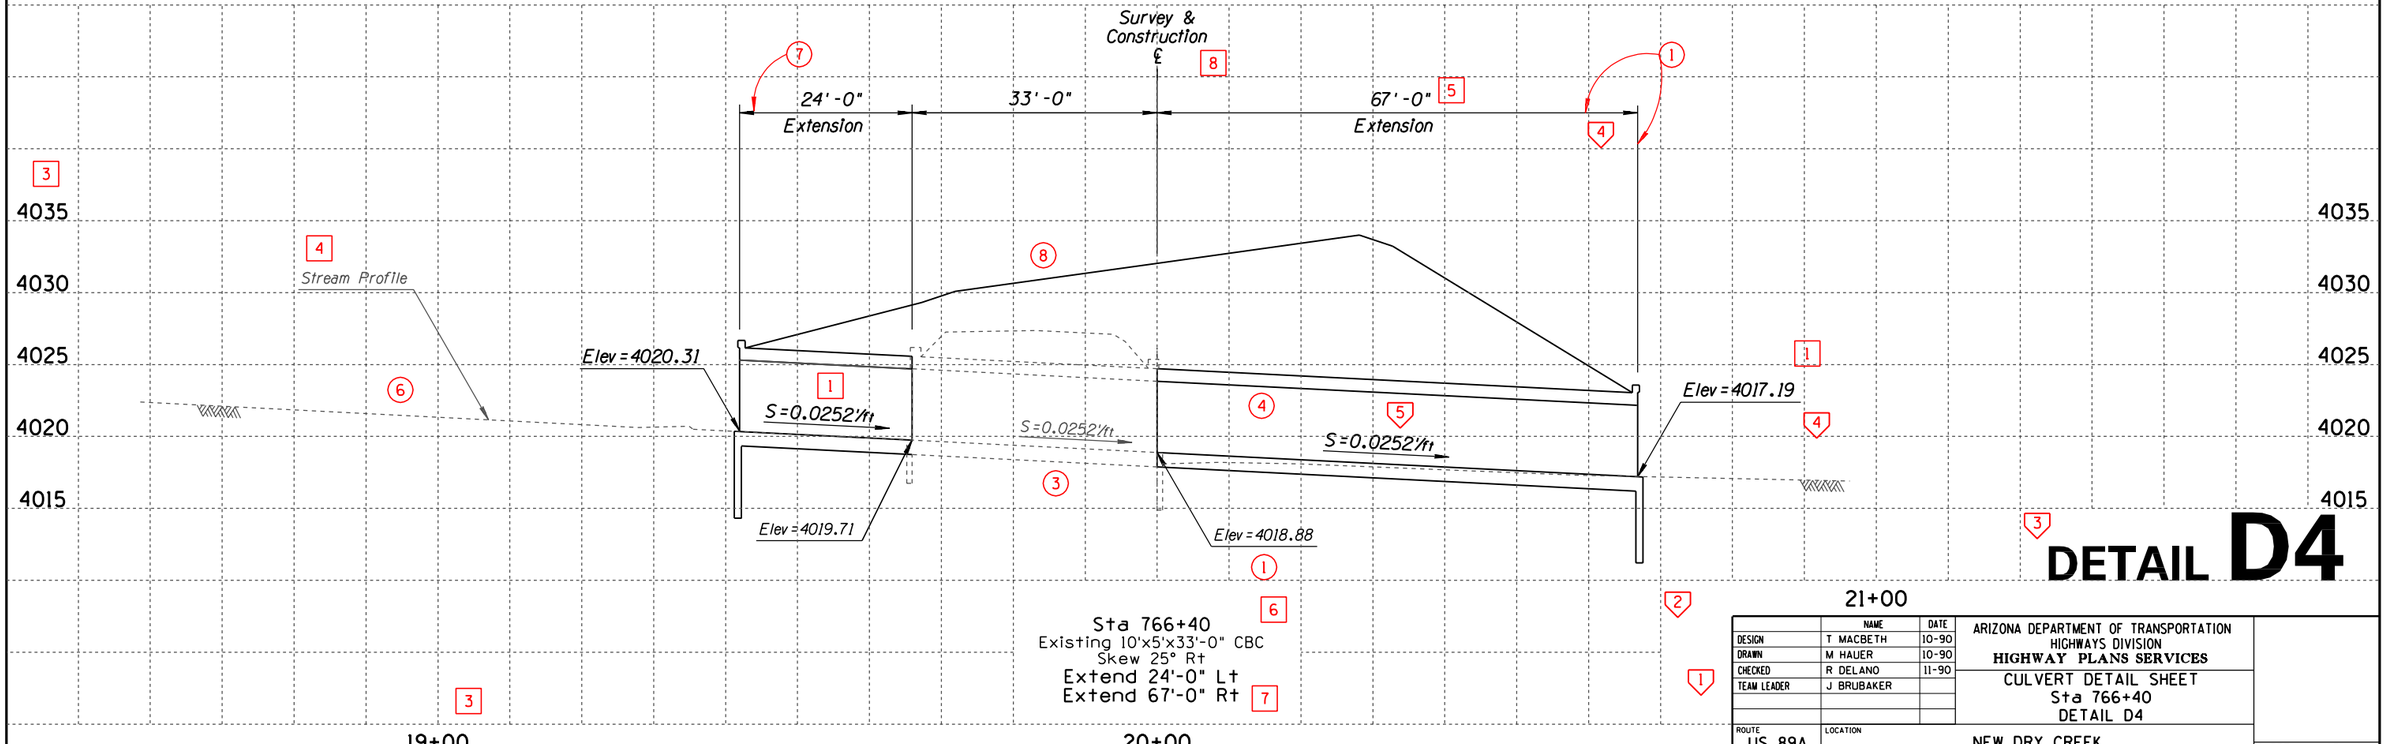

	NAME	DATE
DESIGN	T MACBETH	10-90
DRAWN	M HAUER	10-90
CHECKED	R DELANO	11-90
TEAM LEADER	J BRUBAKER	

ARIZONA DEPARTMENT OF TRANSPORTATION
HIGHWAYS DIVISION
HIGHWAY PLANS SERVICES

CULVERT DETAIL SHEET
Sta 766+40
DETAIL D4

ROUTE: US 89A
LOCATION: NEW DRY CREEK

SHEET 4 OF 6

SURVEY NO. | FINISHED PLANS | REVISIONS | LOCATION | DATE

STD P-05.20

cccccDGNcSPECIFICATIONccccc
cccccSYSTIMEcccccc
VIEW NAME:

TRACS NO. H0000 01 C

___ OF ___