F.H.W.A. REGION	STATE	PROJECT NO.	SHEET NO.	TOTAL SHEETS	AS BUILT
9	ARIZ.	BRS-355(41)	10	35	

089A YV 384

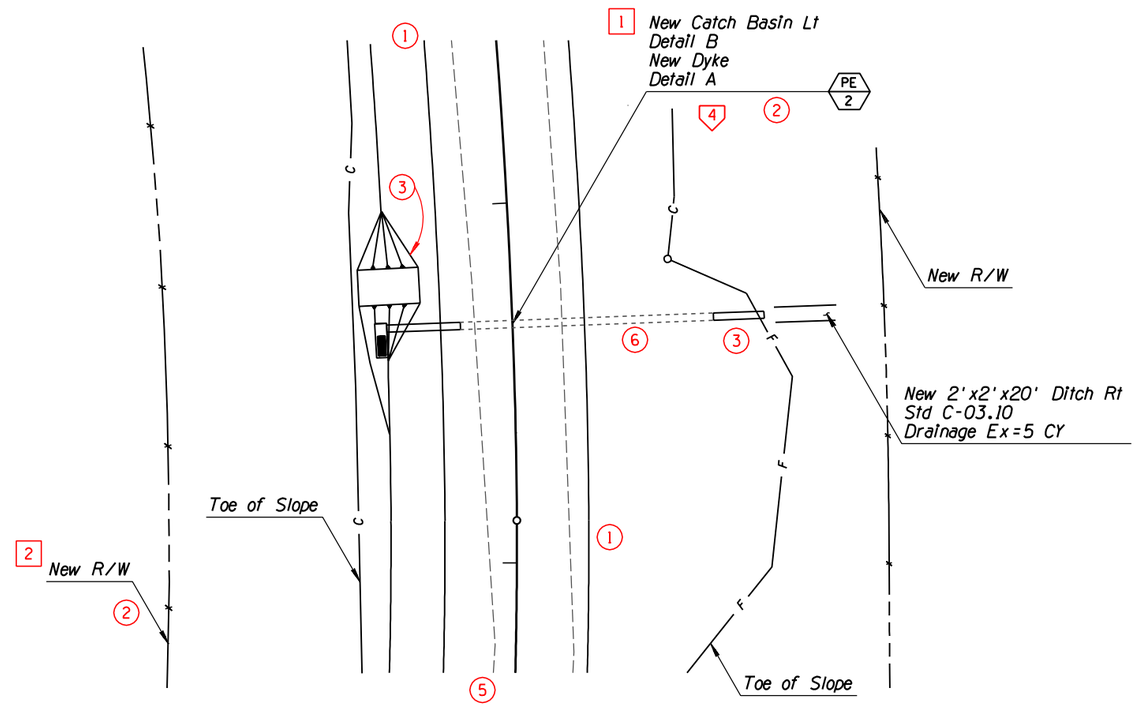

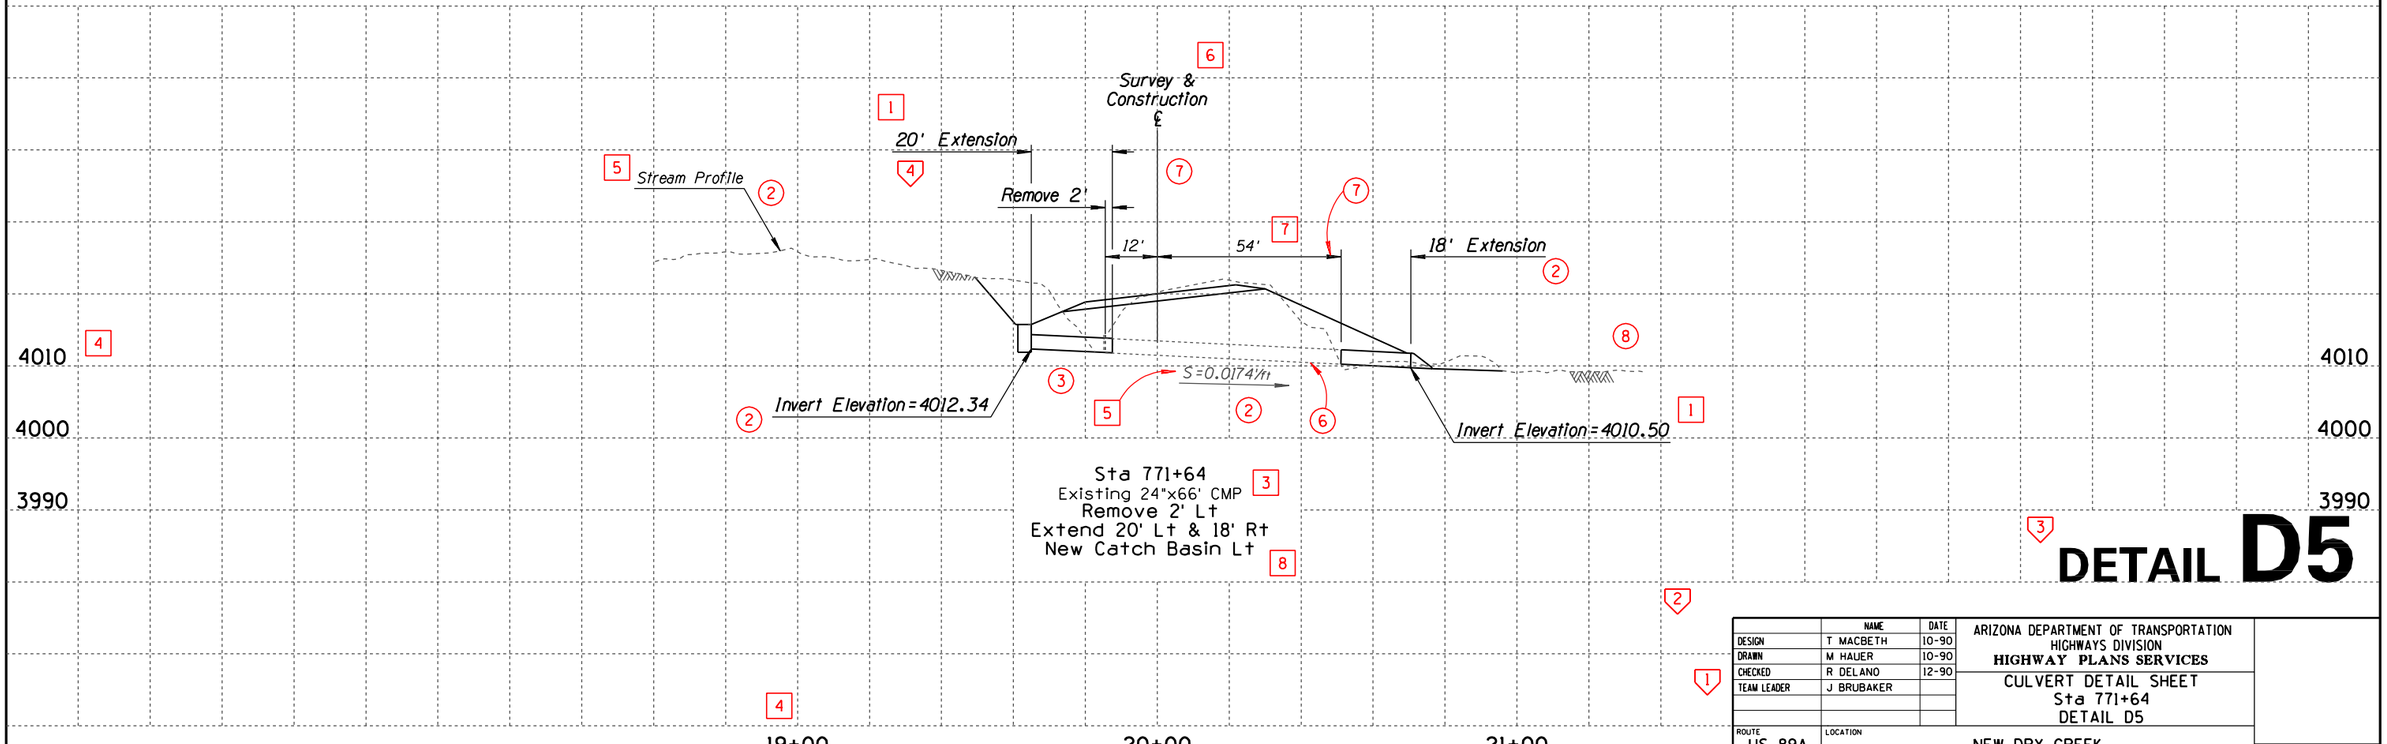

Sta 771+64
Existing 24"x66' CMP
Remove 2' Lt
Extend 20' Lt & 18' Rt
New Catch Basin Lt

DETAIL D5

	NAME	DATE
DESIGN	T MACBETH	10-90
DRAWN	M HAUER	10-90
CHECKED	R DELANO	12-90
TEAM LEADER	J BRUBAKER	

ARIZONA DEPARTMENT OF TRANSPORTATION
HIGHWAYS DIVISION
HIGHWAY PLANS SERVICES

CULVERT DETAIL SHEET
Sta 771+64
DETAIL D5

ROUTE: US 89A
LOCATION: NEW DRY CREEK

SHEET 5 OF 6

TRACS NO. H0000 01 C

___ OF ___

STD P-05.30

SURVEY NO.	FINISHED PLANS	REVISIONS	LOCATION	DATE

cccccDGNcSPECIFICATIONccccc
ccccccSYSTIMEcccccc
VIEW NAME: