| F.H.W.A. REGION | STATE | PROJECT NO. | SHEET NO. | TOTAL SHEETS | AS BUILT |
|---|---|---|---|---|---|
| 9 | ARIZ. | RAM-600-9-500 | 114 | 314 | |

202L MA 147

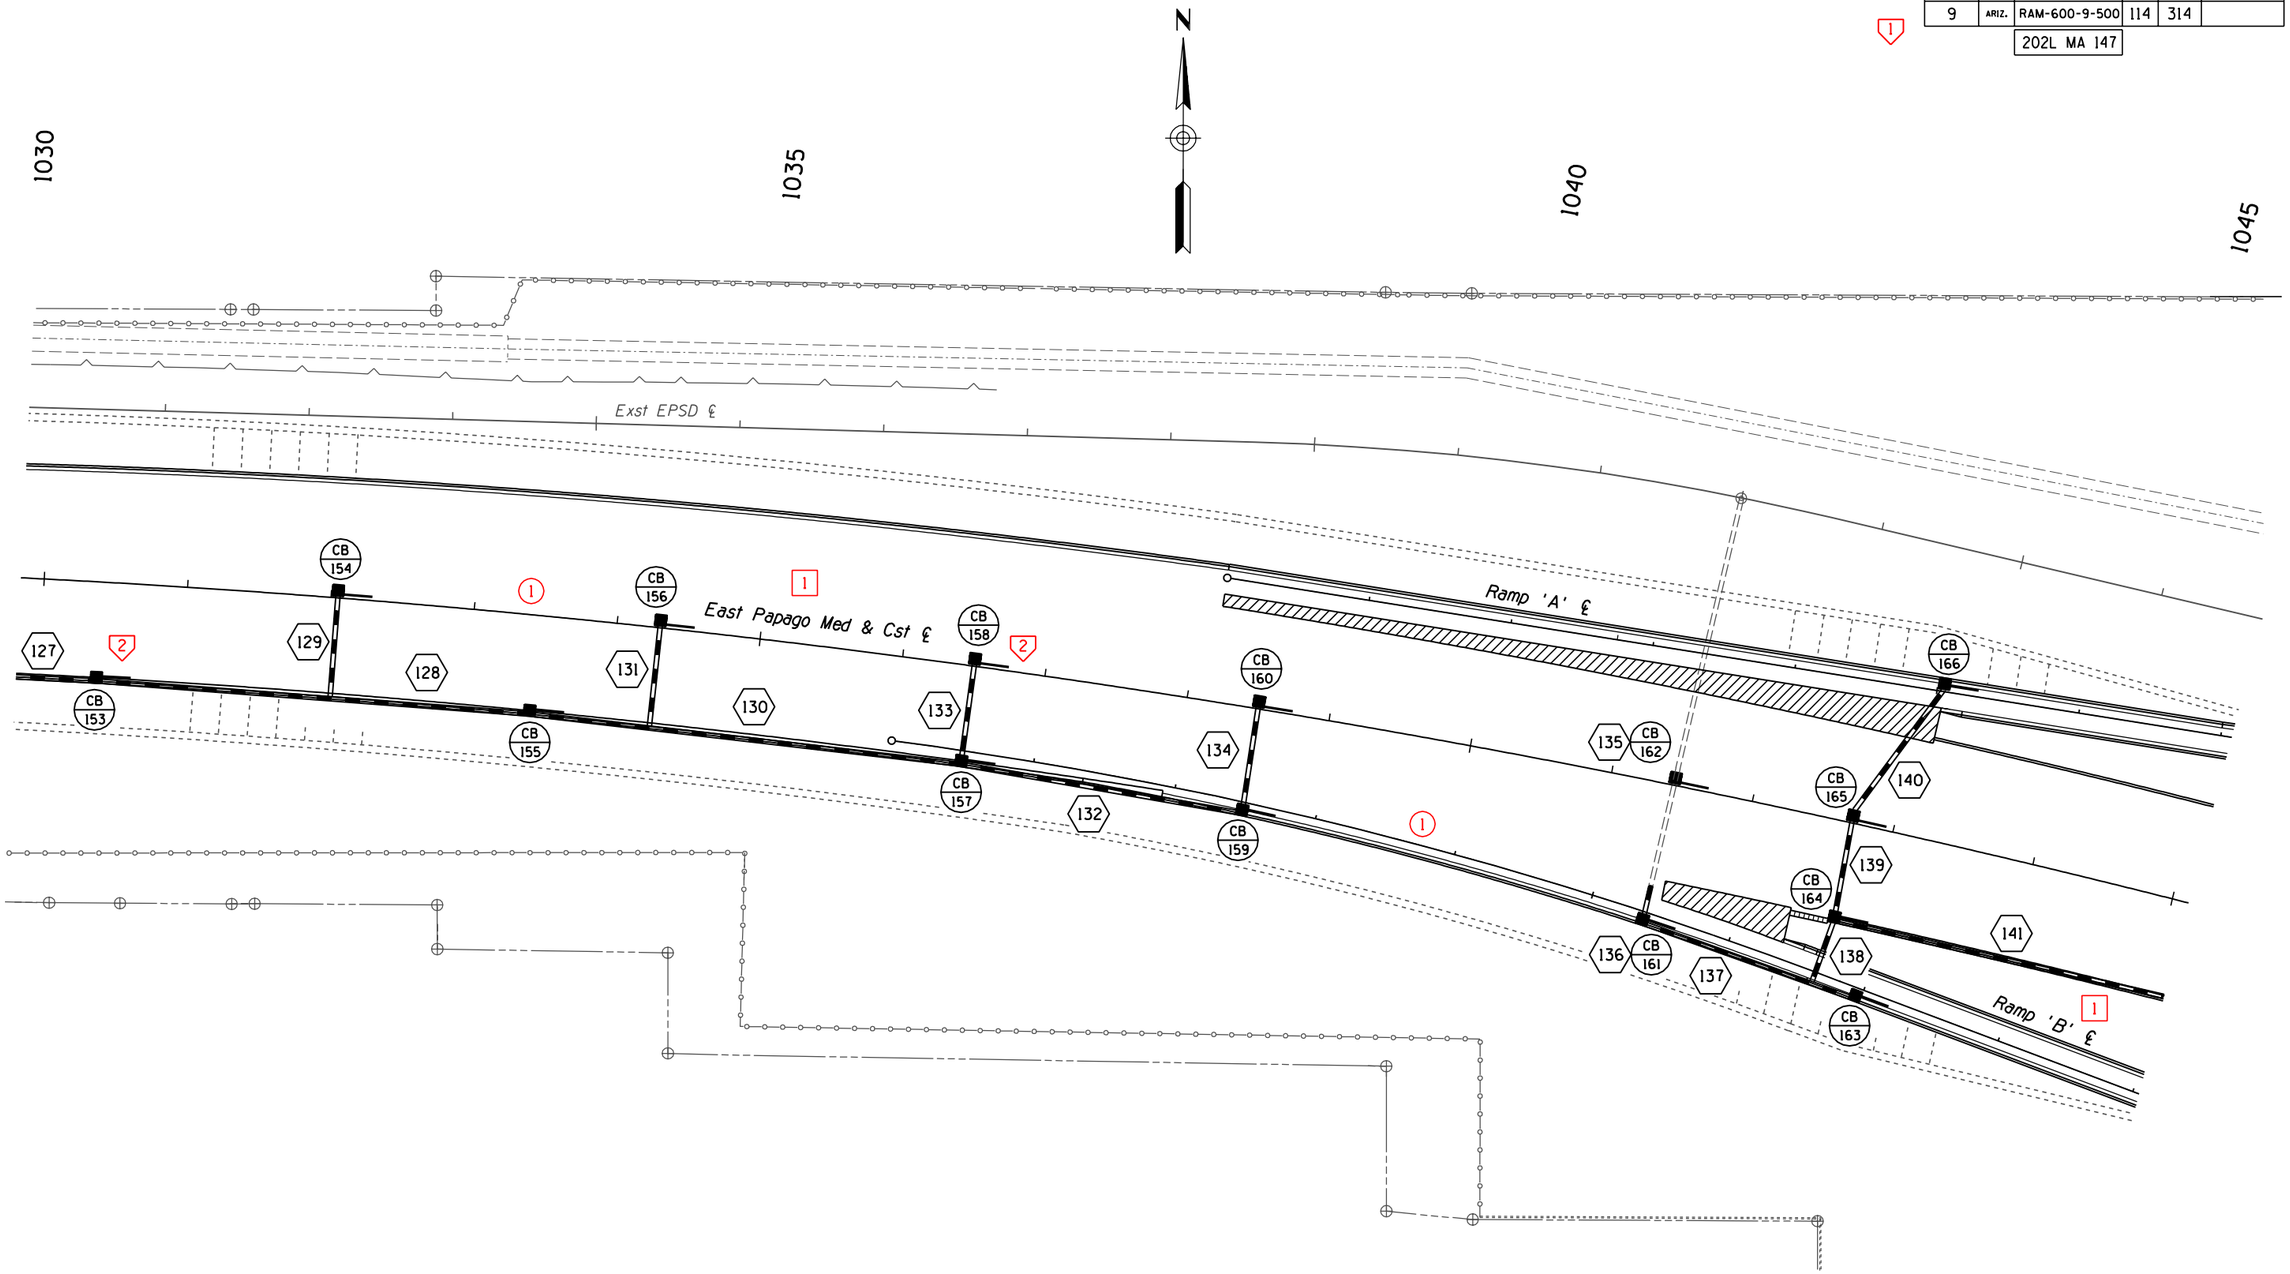


| | NAME | DATE |
|---|---|---|
| DESIGN | T MACBETH | 10-90 |
| DRAWN | M HAUER | 10-90 |
| CHECKED | R DELANO | 11-90 |
| TEAM LEADER | J BRUBAKER | |

ARIZONA DEPARTMENT OF TRANSPORTATION
HIGHWAYS DIVISION
**HIGHWAY PLANS SERVICES**

EAST PAPAGO MAINLINE
STORM DRAIN PLAN
Sta 1030+00 to 1045+00

ROUTE 202L

LOCATION JCT I-10 - 40th STREET

SHEET 3 OF 11

| SURVEY NO. | FINISHED PLANS | REVISIONS | LOCATION | DATE |
|---|---|---|---|---|
| | | | | |

cccccDGNcSPECIFICATIONccccc
cccccSYSTIMEcccccc

VIEW NAME:

TRACS NO.

___ OF ___

STD P-12.10