F.H.W.A. REGION	STATE	PROJECT NO.	SHEET NO.	TOTAL SHEETS	AS BUILT
9	ARIZ.	M-100-1-100	60	145	

101L MA 45

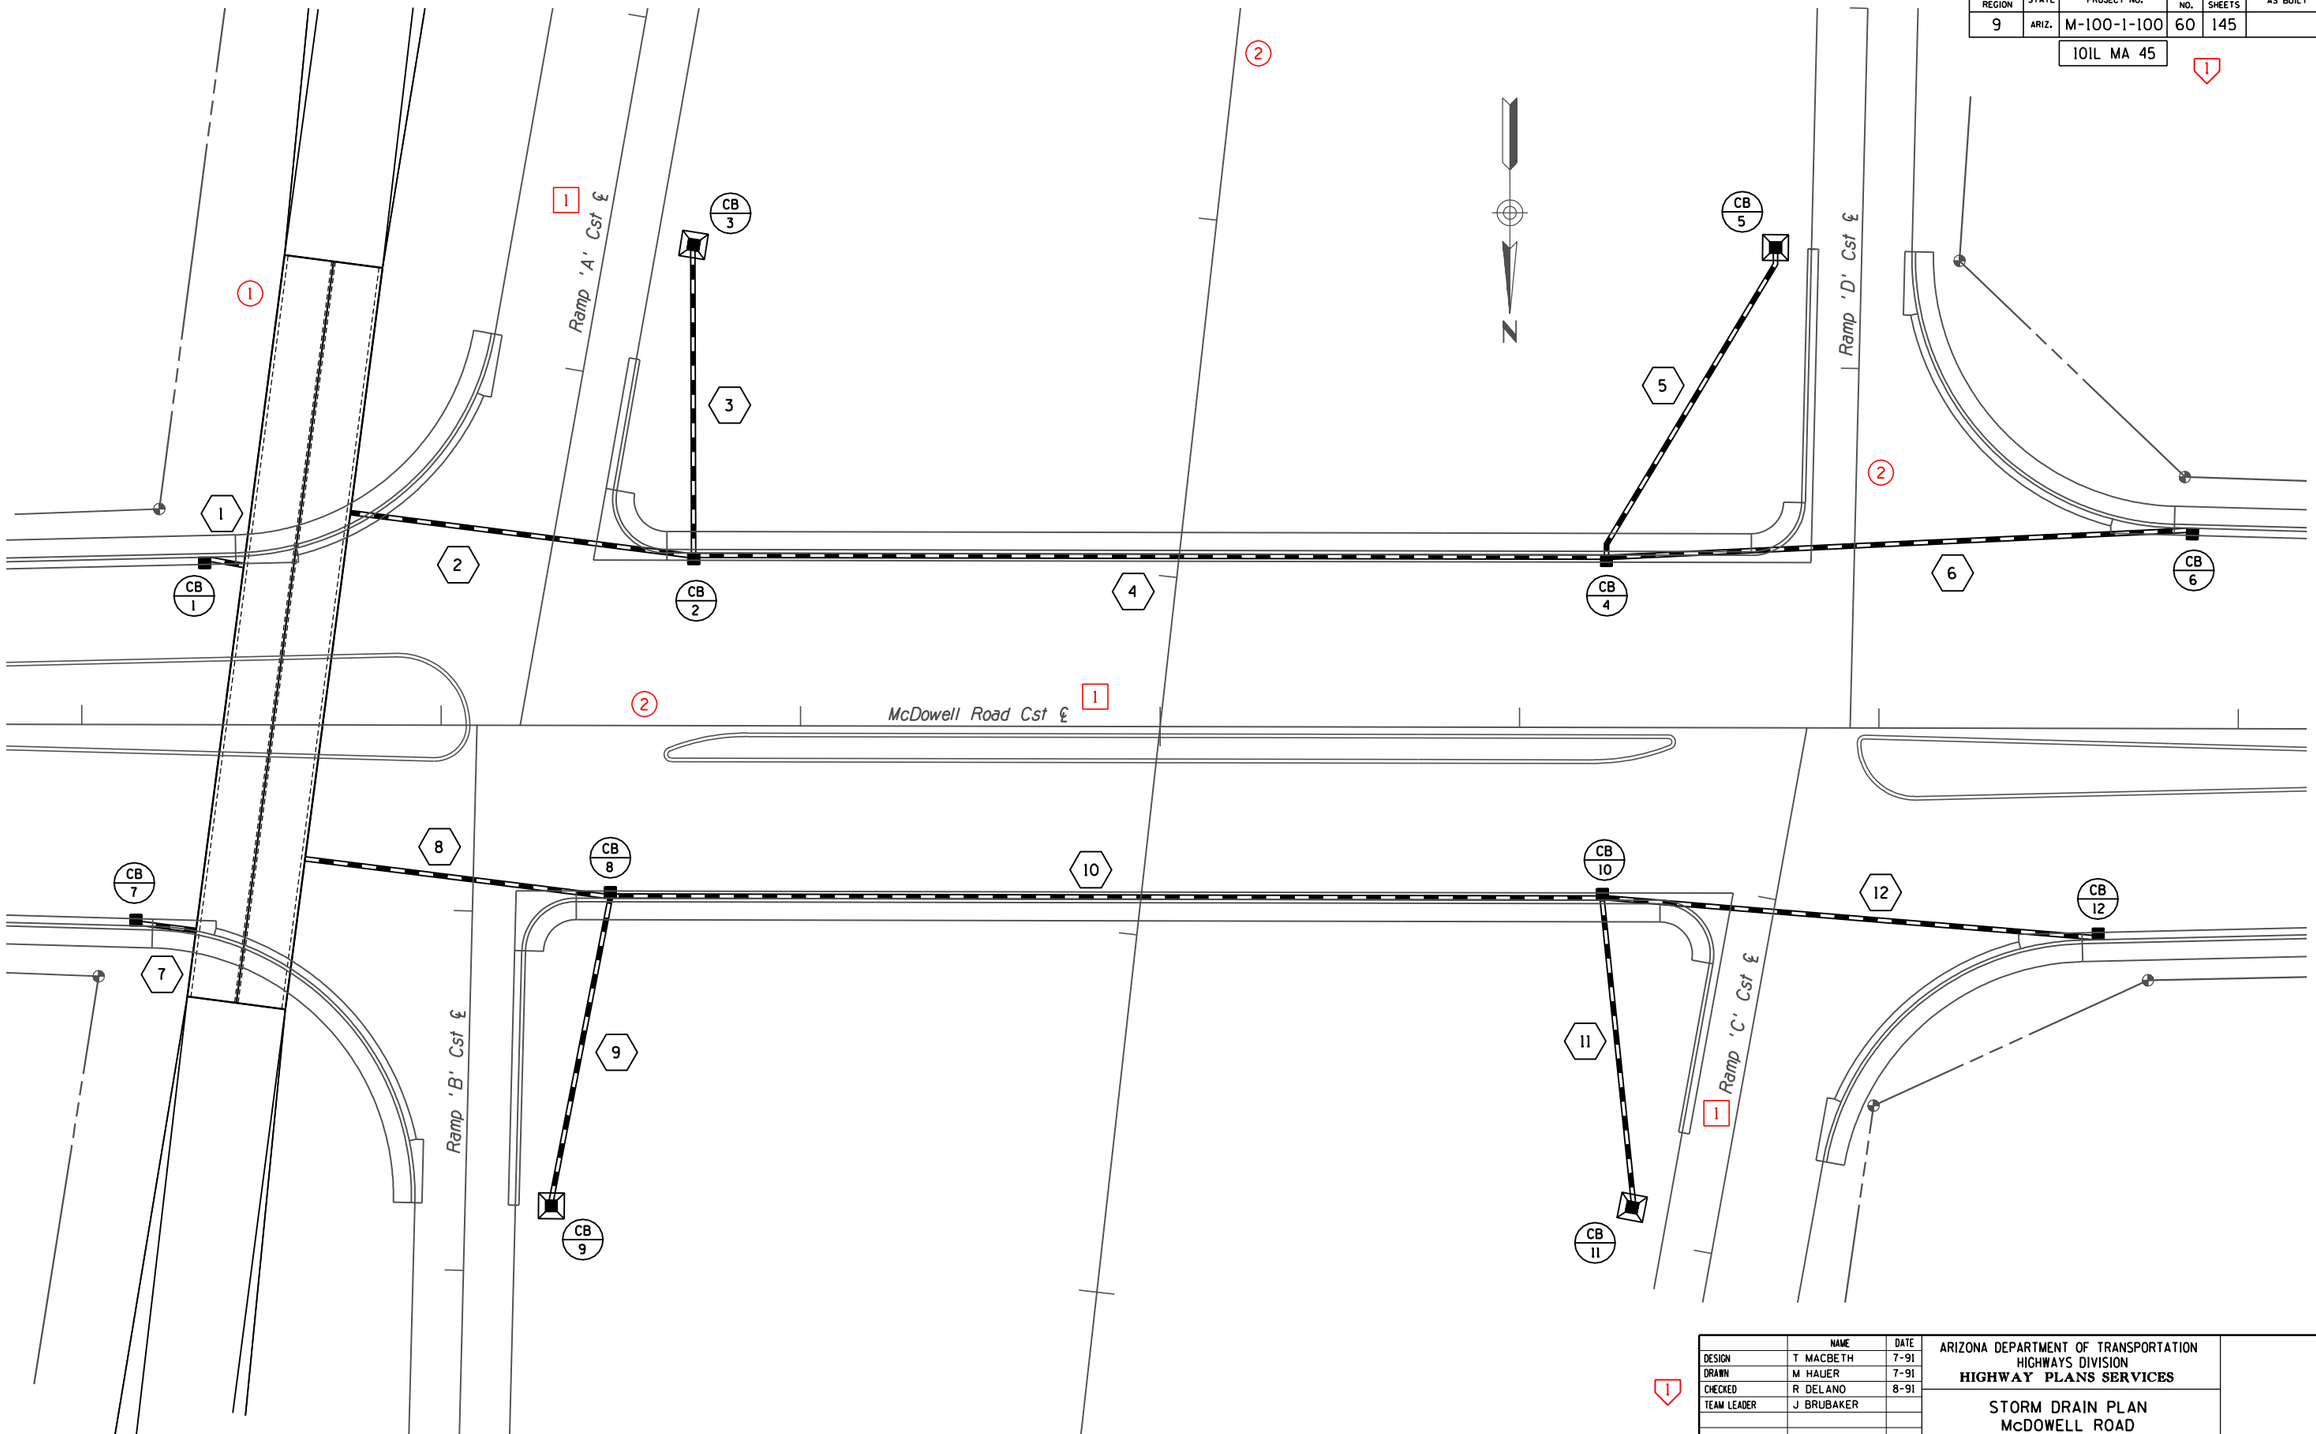

	NAME	DATE
DESIGN	T MACBETH	7-91
DRAWN	M HAUER	7-91
CHECKED	R DELANO	8-91
TEAM LEADER	J BRUBAKER	

ARIZONA DEPARTMENT OF TRANSPORTATION
HIGHWAYS DIVISION
HIGHWAY PLANS SERVICES

STORM DRAIN PLAN
McDOWELL ROAD

ROUTE 101L

LOCATION PIMA, CHAPARRAL - MCKELLIPS

SHEET 1 OF 5

SURVEY NO.	FINISHED PLANS	REVISIONS	LOCATION	DATE

cccccDGNcSPECIFICATIONccccc
cccccSYSTIMEccccc

VIEW NAME:

TRACS NO. H2409 01 C

___ OF ___

STD P-12.15