F.H.W.A. REGION	STATE	PROJECT NO.	SHEET NO.	TOTAL SHEETS	AS BUILT
9	ARIZ.	B-063-1-610	48	79	
		095 YU 020			

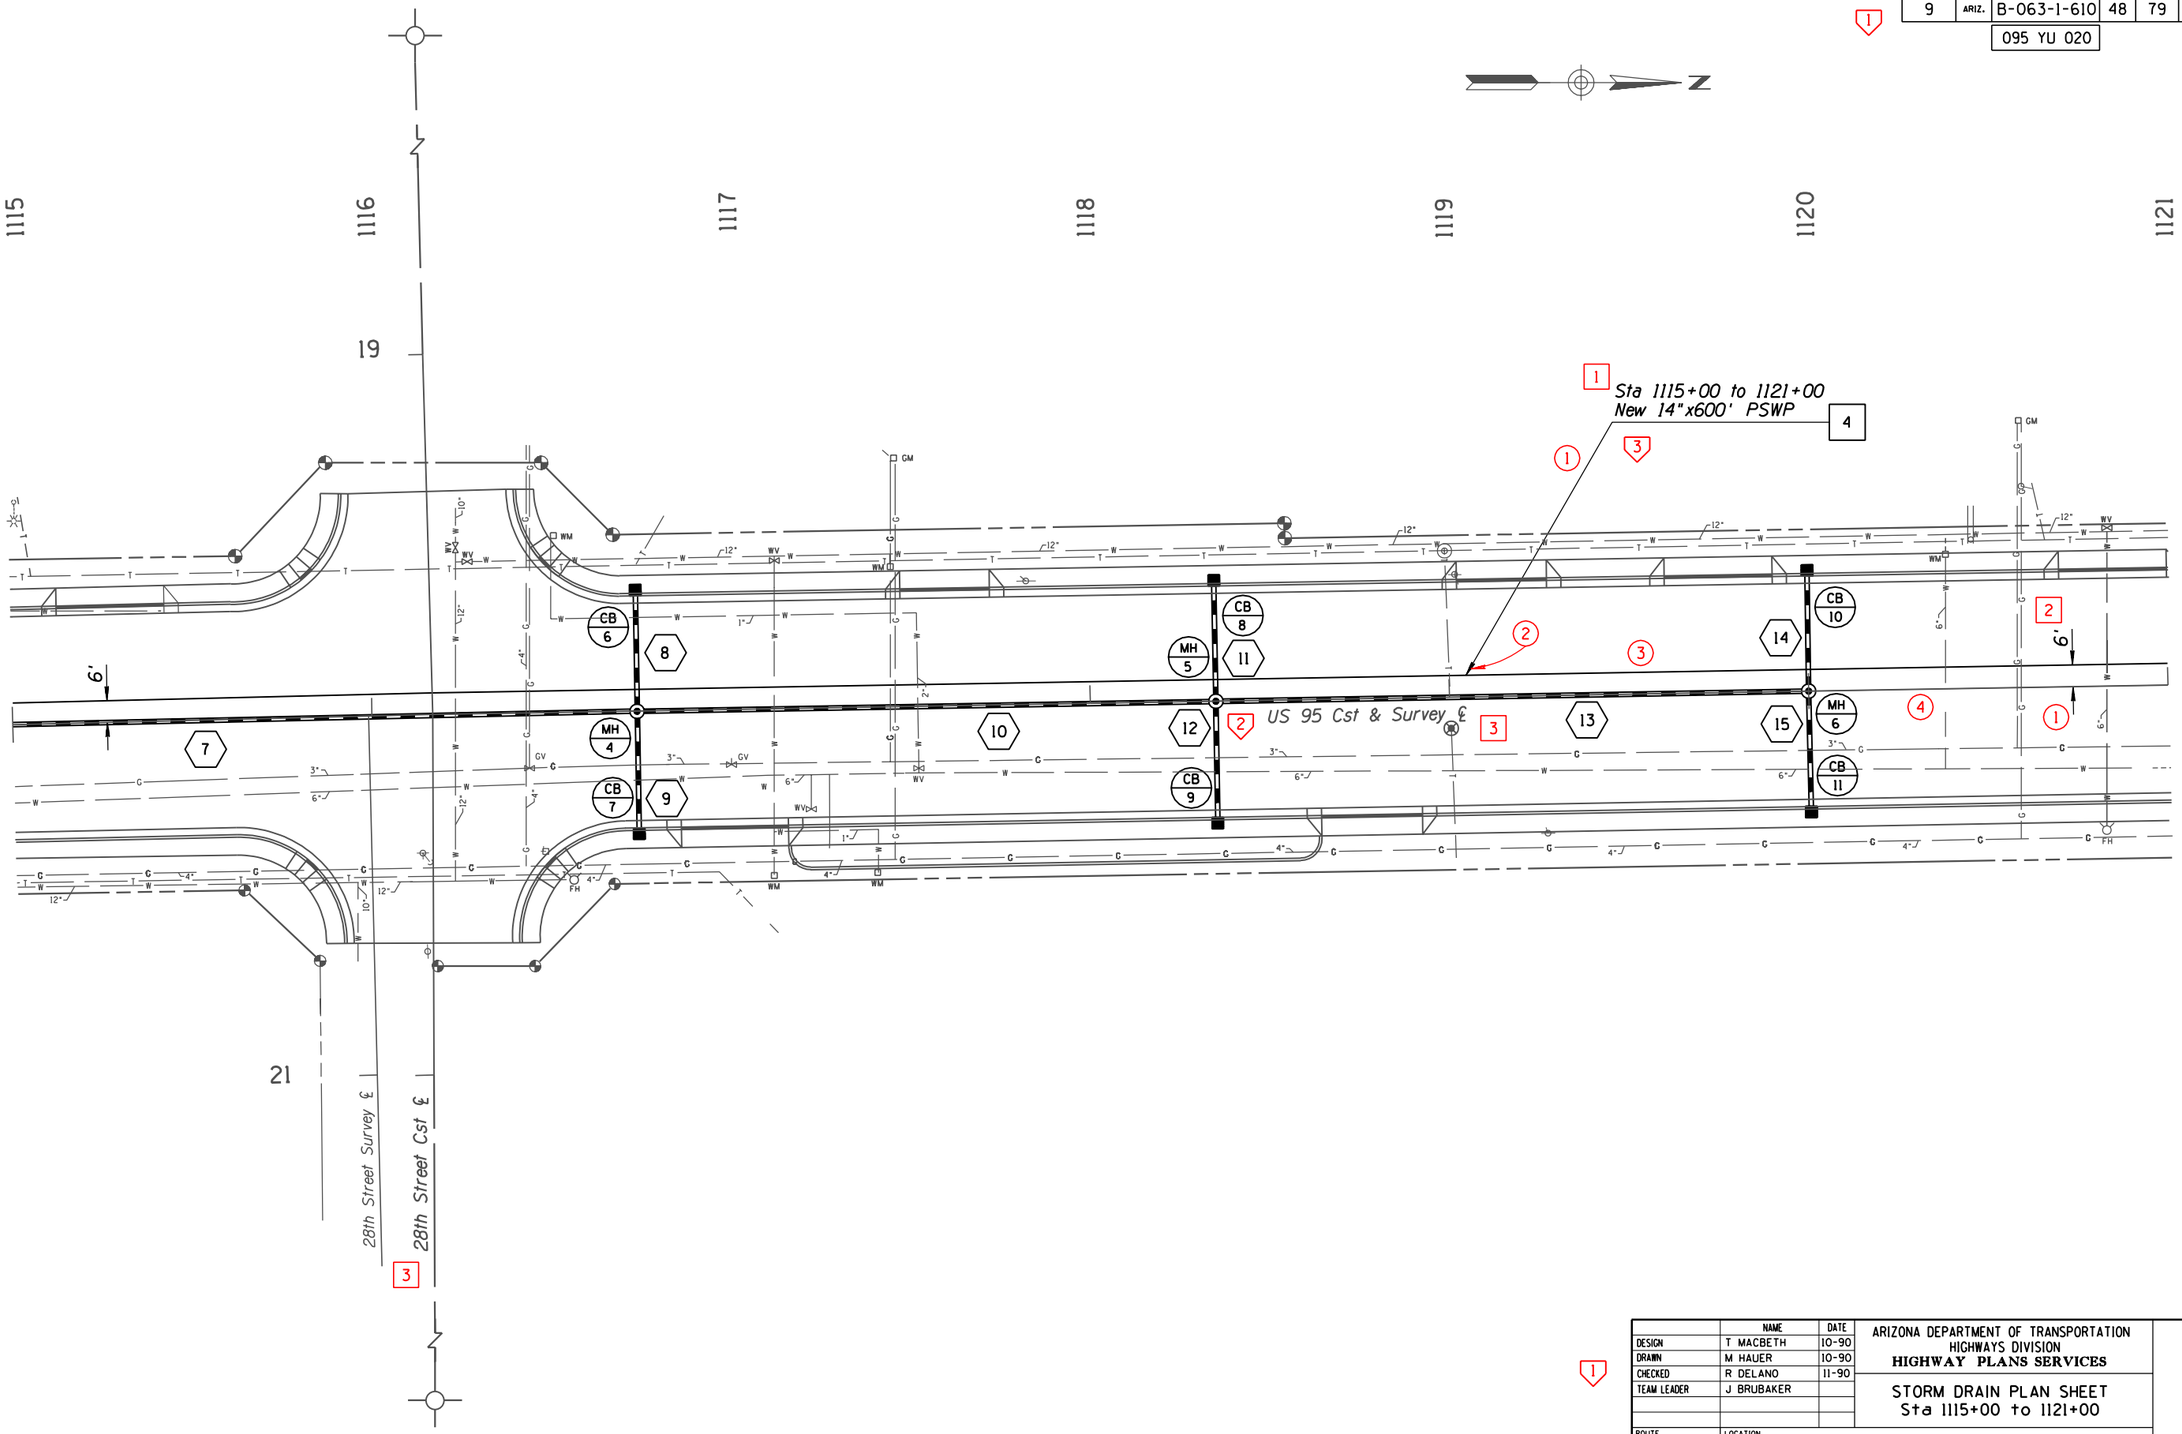

	NAME	DATE
DESIGN	T MACBETH	10-90
DRAWN	M HAUER	10-90
CHECKED	R DELANO	11-90
TEAM LEADER	J BRUBAKER	

ARIZONA DEPARTMENT OF TRANSPORTATION
HIGHWAYS DIVISION
HIGHWAY PLANS SERVICES

STORM DRAIN PLAN SHEET
Sta 1115+00 to 1121+00

ROUTE: US 95
LOCATION: 32nd ST - 26th ST (YUMA)

SHEET 10 OF 11

SURVEY NO.	FINISHED PLANS	REVISIONS	LOCATION	DATE

cccccDGNcSPECIFICATIONccccc
ccccccSYSTIMEcccccc
VIEW NAME:

TRACS NO. H0000 01 C

___ OF ___

STD P-12.20