F.H.W.A. REGION	STATE	PROJECT NO.	SHEET NO.	TOTAL SHEETS	AS BUILT
9	ARIZ.	RAM-600-9-500	114	314	

202L MA 147

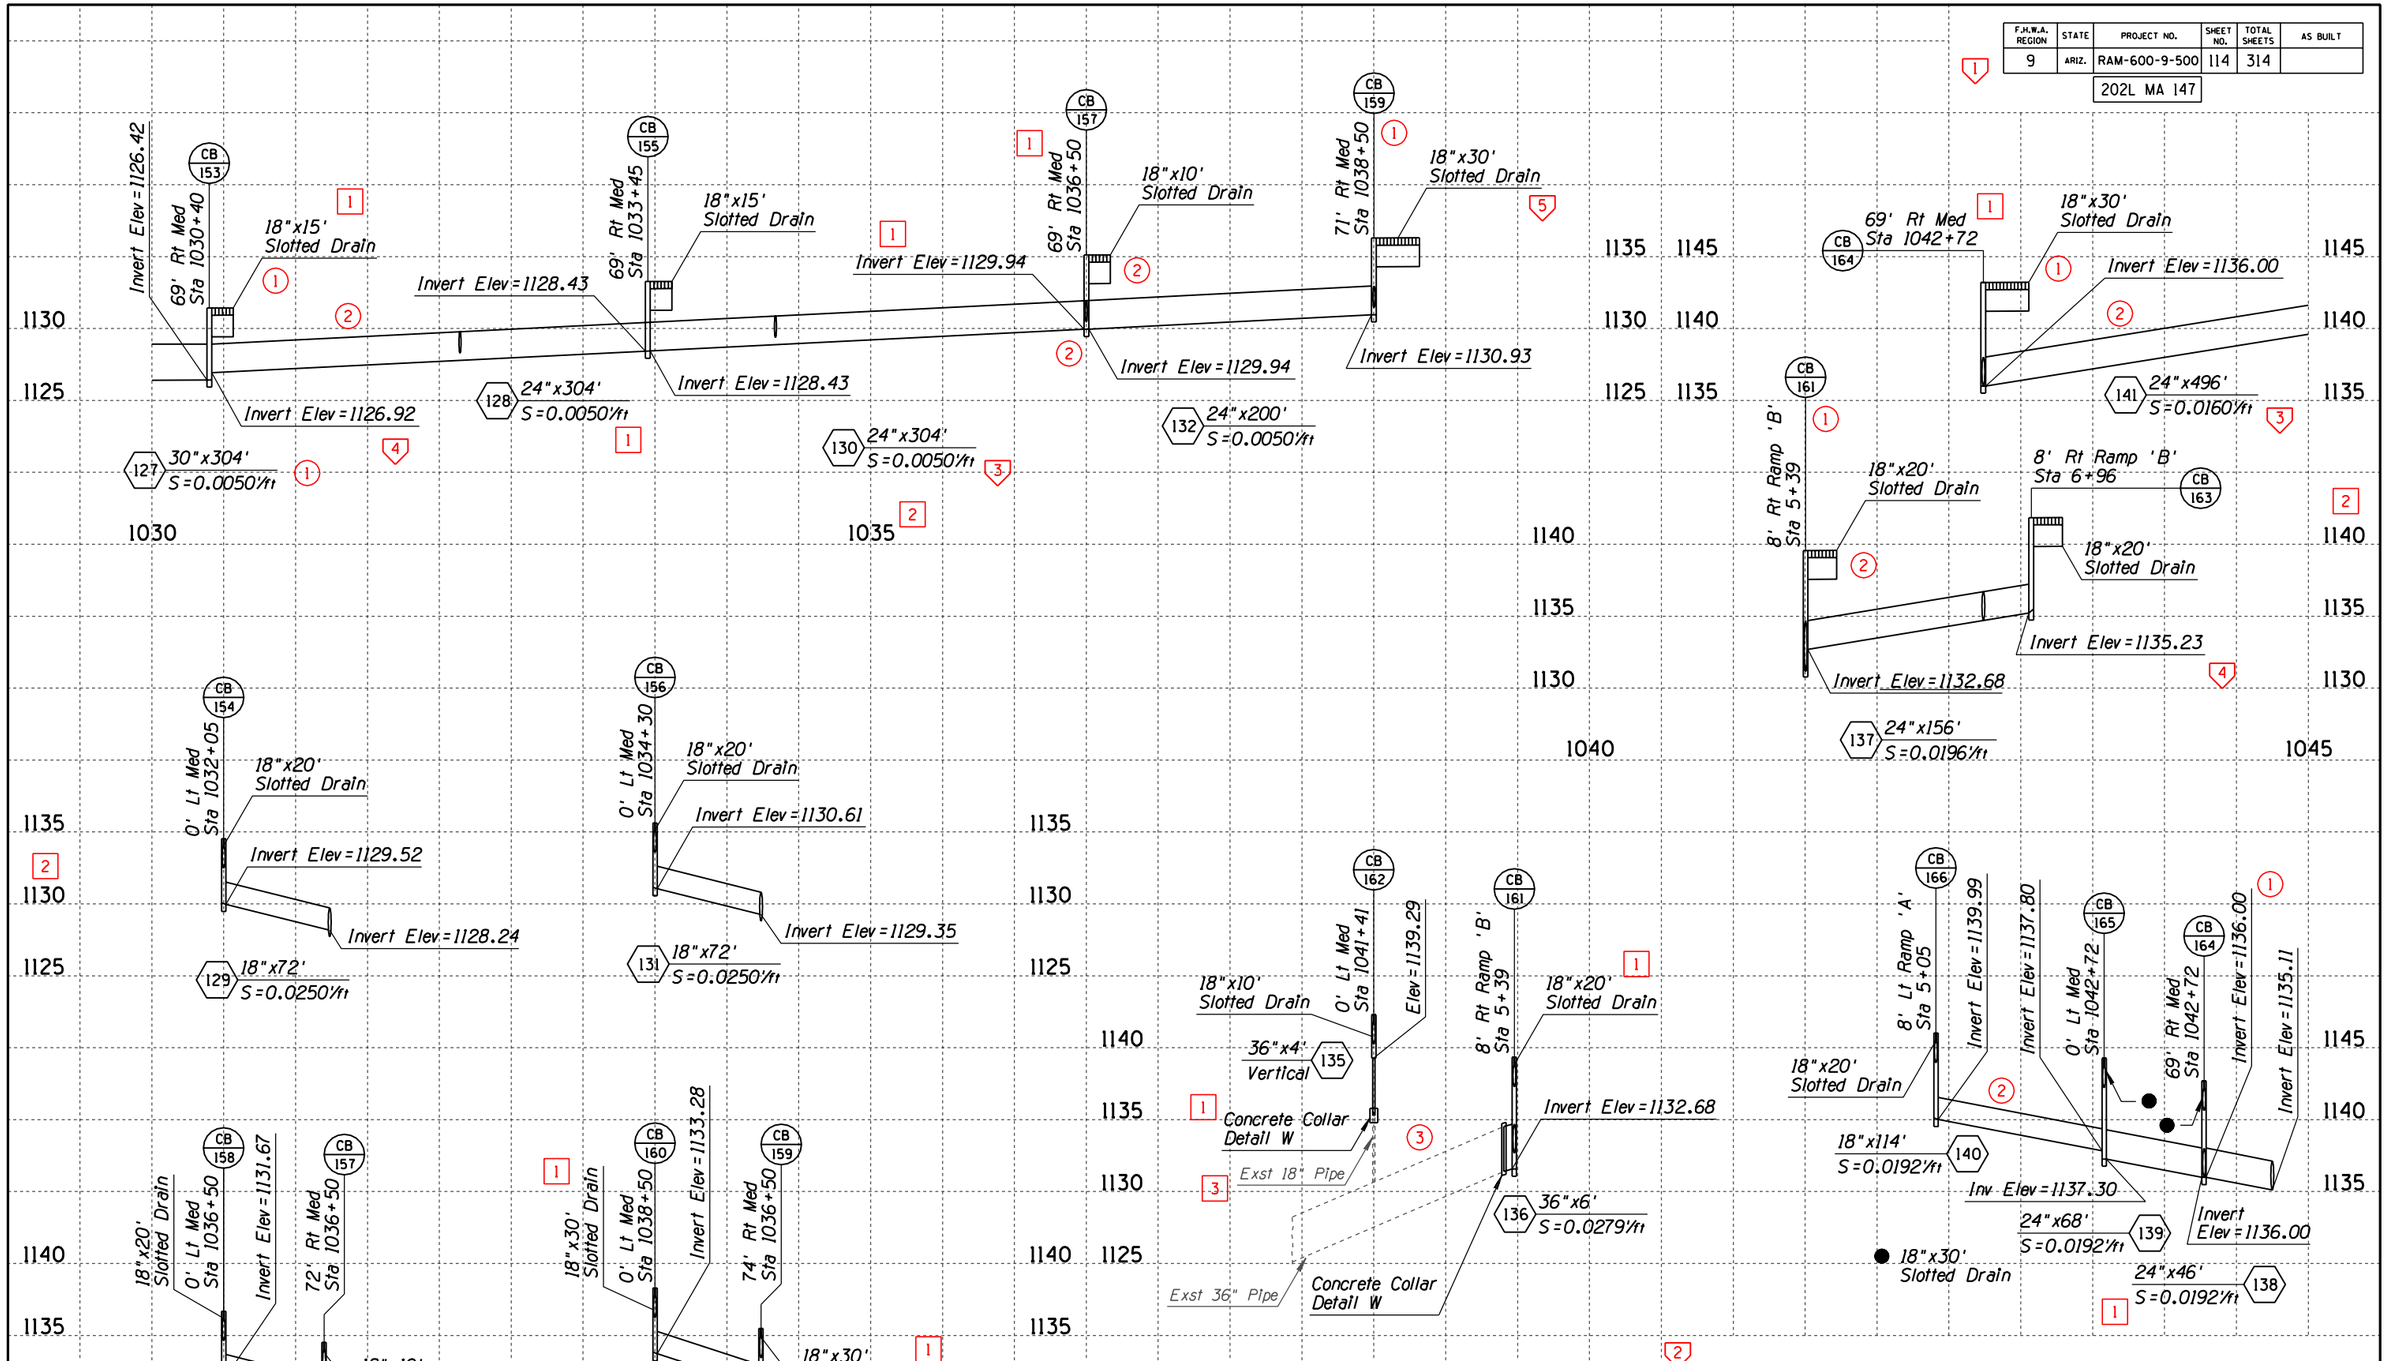

	NAME	DATE
DESIGN	T MACBETH	10-90
DRAWN	M HAUER	10-90
CHECKED	R DELANO	12-90
TEAM LEADER	J BRUBAKER	

ARIZONA DEPARTMENT OF TRANSPORTATION
HIGHWAYS DIVISION
HIGHWAY PLANS SERVICES

EAST PAPAGO MAINLINE
STORM DRAIN PROFILE SHEET
Sta 1030+00 to 1045+00

ROUTE 202L
LOCATION JCT I-10 - 40th STREET

SHEET 4 OF 40

STD P-13.10

SURVEY NO. | FINISHED PLANS | REVISIONS | LOCATION | DATE

ccccc DGNcSPECIFICATIONccccc
ccccc SYSTIMEccccc
VIEW NAME:

TRACS NO. H0000 01 C

___ OF ___