F.H.W.A. REGION	STATE	PROJECT NO.	SHEET NO.	TOTAL SHEETS	AS BUILT
9	ARIZ.	M-100-1-100	69	145	

101L MA 45

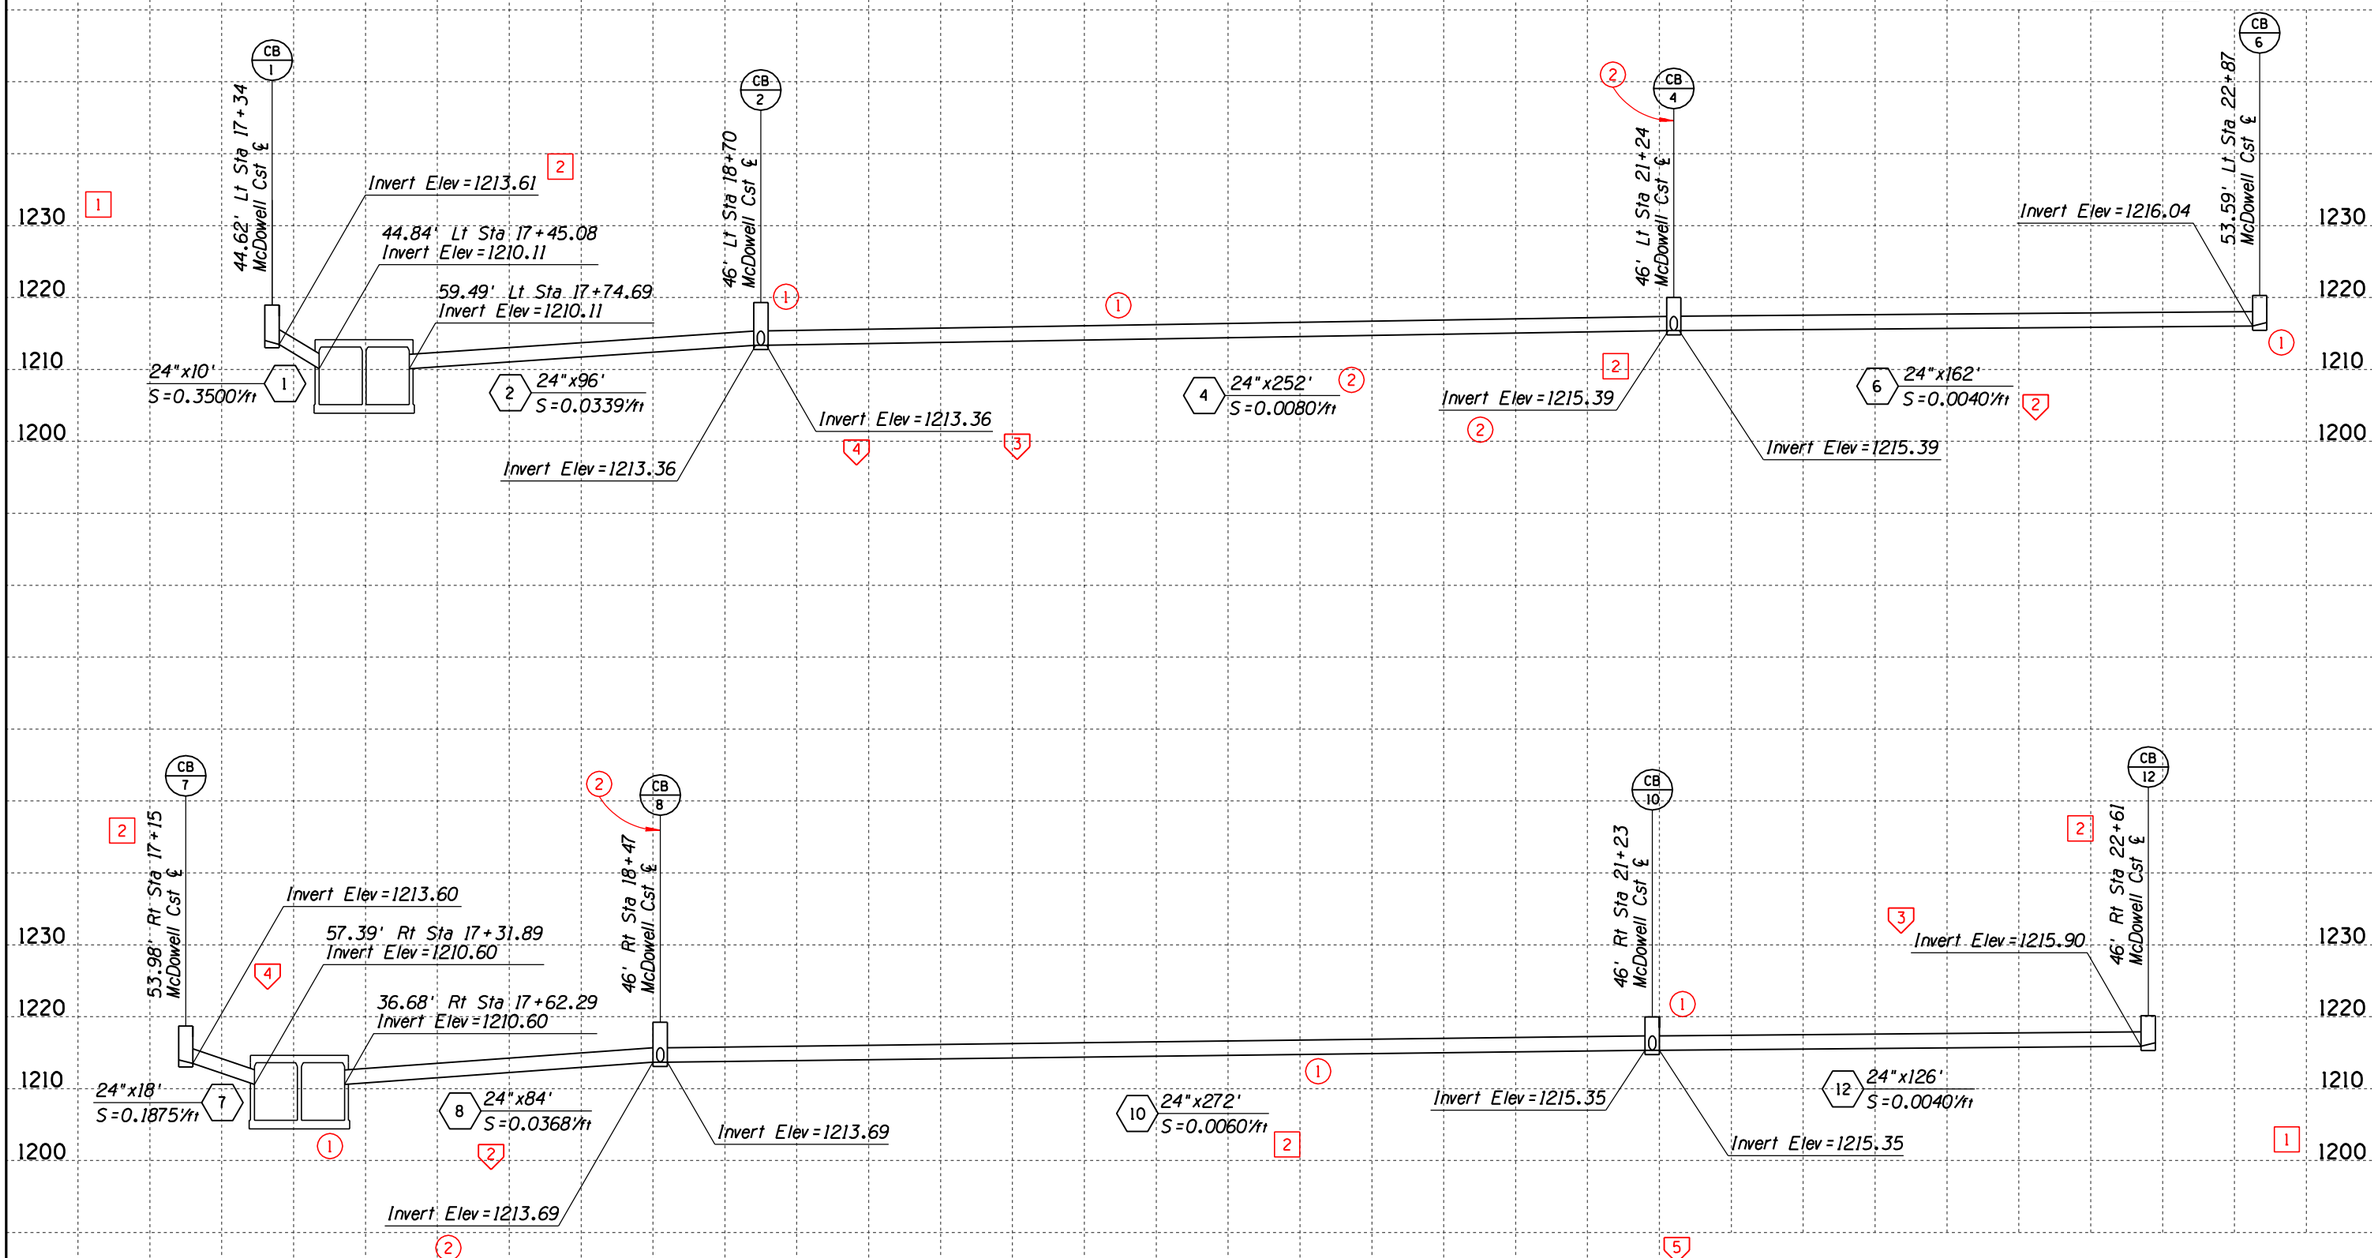

	NAME	DATE
DESIGN	T MACBETH	7-91
DRAWN	M HAUER	7-91
CHECKED	R DELANO	8-91
TEAM LEADER	J BRUBAKER	

ARIZONA DEPARTMENT OF TRANSPORTATION
HIGHWAYS DIVISION
HIGHWAY PLANS SERVICES

STORM DRAIN PROFILE
McDOWELL ROAD

ROUTE 101L

LOCATION PIMA, CHAPARRAL - MCKELLIPS

SHEET 1 OF 8

STD P-13.15

SURVEY NO. | FINISHED PLANS | REVISIONS | LOCATION | DATE

cccccDGNcSPECIFICATIONccccc
ccccc SYSTIMEccccc

VIEW NAME:

TRACS NO.

___ OF ___