F.H.W.A. REGION	STATE	PROJECT NO.	SHEET NO.	TOTAL SHEETS	AS BUILT
9	ARIZ.	B-063-1-610	3	79	
		095 YU 020			

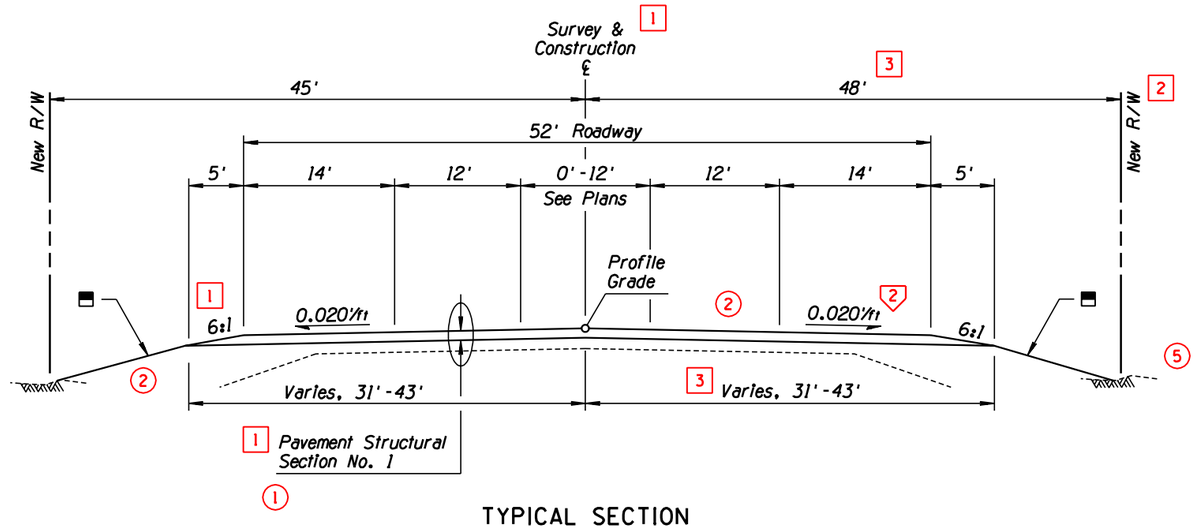

TYPICAL SECTION

Sta 1086+00 to 1089+02.07

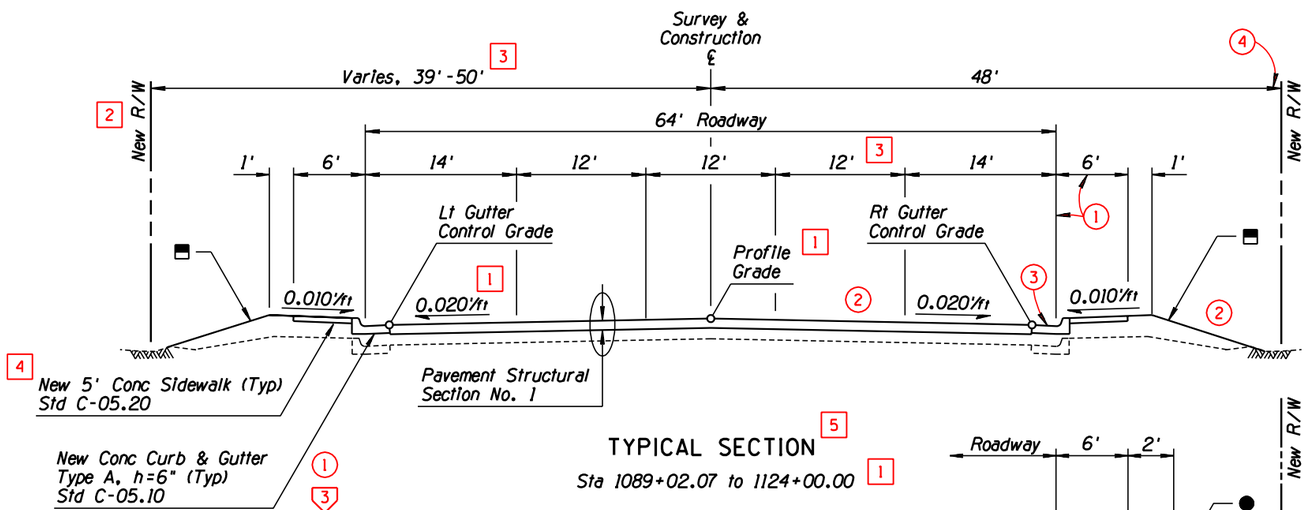

TYPICAL SECTION

Sta 1089+02.07 to 1124+00.00

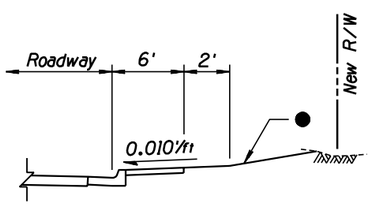

Rt Sta 1091+50 to 1093+00

■ Slopes Vary, Hold 1' Inside R/W

● 6:1 Slope or Hold 1' Inside R/W

	NAME	DATE
DESIGN	T MACBETH	10-90
DRAWN	M HAUER	10-90
CHECKED	R DELANO	12-90
TEAM LEADER	J BRUBAKER	

ARIZONA DEPARTMENT OF TRANSPORTATION
HIGHWAYS DIVISION
HIGHWAY PLANS SERVICES

DESIGN SHEET
TYPICAL SECTIONS

ROUTE: US 95
LOCATION: 32nd ST - 26th ST (YUMA)

SHEET 2 OF 2

SURVEY NO.	FINISHED PLANS	REVISIONS	LOCATION	DATE

STD P-02.31

CCCCCDGNCSPECIFICATIONCCCCC
CCCCCSYSTIMECCCCC
VIEW NAME:

TRACS NO. H0000 01 C

___ OF ___